


1 LOCATION OF WATER WELL: County: SEDGWICK Fraction: SE $\frac{1}{4}$ SW $\frac{1}{4}$ NE $\frac{1}{4}$ Section Number: 33 Township Number: T 27 S Range Number: R 1 EW

Distance and direction from nearest town or city street address of well if located within city?

MW-255

2 WATER WELL OWNER: Learyet
RR#, St. Address, Box #: One Learyet Way
City, State, ZIP Code: Wichita, KS 67209
Board of Agriculture, Division of Water Resources
Application Number:

3 LOCATE WELL'S LOCATION WITH AN "X" IN SECTION BOX:

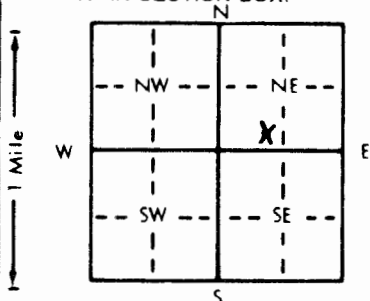

4 DEPTH OF COMPLETED WELL: 40 ft. ELEVATION:

Depth(s) Groundwater Encountered 1. ft. 2. ft. 3. ft.

WELL'S STATIC WATER LEVEL: 29.13 ft. below land surface measured on mo/day/yr 1/95

Pump test data: Well water was ft. after hours pumping gpm

Est. Yield gpm Well water was ft. after hours pumping gpm

Bore Hole Diameter: 8 in. to 40 ft., and in. to ft.

WELL WATER TO BE USED AS:

5 Public water supply 8 Air conditioning 11 Injection well

1 Domestic 3 Feedlot 6 Oil field water supply 9 Dewatering 12 Other (Specify below)

2 Irrigation 4 Industrial 7 Lawn and garden only 10 Monitoring well

Was a chemical/bacteriological sample submitted to Department? Yes No X; If yes, mo/day/yr sample was submitted

Water Well Disinfected? Yes No X

5 TYPE OF BLANK CASING USED:

1 Steel 3 RMP (SR) 5 Wrought iron 8 Concrete tile CASING JOINTS: Glued Clamped

2 PVC 4 ABS 6 Asbestos-Cement 9 Other (specify below) Welded

Blank casing diameter: 2 in. to 25 ft. Dia. in. to ft. Dia. in. to ft.

Casing height above land surface: 18 in. weight: .69 lbs./ft. Wall thickness or gauge No.

TYPE OF SCREEN OR PERFORATION MATERIAL:

1 Steel 3 Stainless steel 5 Fiberglass 8 RMP (SR) 10 Asbestos-cement

2 Brass 4 Galvanized steel 6 Concrete tile 9 ABS 11 Other (specify)

SCREEN OR PERFORATION OPENINGS ARE:

1 Continuous slot 3 Mill slot 5 Gauzed wrapped 8 Saw cut 11 None (open hole)

2 Louvered shutter 4 Key punched 6 Wire wrapped 9 Drilled holes

SCREEN-PERFORATED INTERVALS: From 25 ft. to 40 ft. From ft. to ft.

GRAVEL PACK INTERVALS: From 20 ft. to 40 ft. From ft. to ft.

From ft. to ft. From ft. to ft.

From ft. to ft. From ft. to ft.

7 CONTRACTOR'S OR LANDOWNER'S CERTIFICATION: This water well was 1 constructed, 2 reconstructed, or 3 plugged under my jurisdiction and was completed on (mo/day/year) 2-1-95 and this record is true to the best of my knowledge and belief. Kansas

Water Well Contractor's License No. 581 This Water Well Record was completed on (mo/day/yr) 2-1-95

under the business name of Leary, Inc. by (signature) Steven R. Mitchell

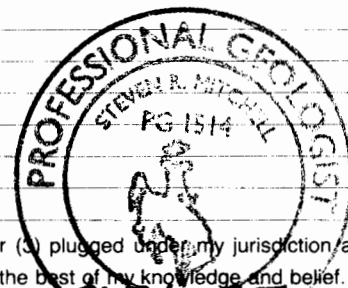

OFFICE USE ONLY

T

R

EW

SEC.

1/4

1/4

1/4