

1 LOCATION OF WATER WELL County: Kingman	Fraction SE 1/4 SW 1/4 SE 1/4	Section Number 11	Township Number T 27 S	Range Number R 10W E/W
---	---	-----------------------------	----------------------------------	----------------------------------

Distance and direction from nearest town or city? **4 N, 2 1/2 E of Cunningham, Kansas**
 Street address of well if located within city?


2 WATER WELL OWNER: **Graves Drilling Co., Inc.**
 RR#, St. Address, Box # : **910 Union Center**
 City, State, ZIP Code : **Wichita, Kansas 67202**
 Board of Agriculture, Division of Water Resources
 Application Number: **Unknown**

3 DEPTH OF COMPLETED WELL... **140** ft. Bore Hole Diameter... **8** in. to **140** ft. and ... in. to ... ft.
 Well Water to be used as:
 5 Public water supply 8 Air conditioning 11 Injection well
 1 Domestic 3 Feedlot 6 Oil field water supply 9 Dewatering 12 Other (Specify below)
 2 Irrigation 4 Industrial 7 Lawn and garden only 10 Observation well
 Well's static water level... **59** ft. below land surface measured on... **3** month... **13** day... **1981** year
 Pump Test Data : Well water was ... ft. after ... hours pumping... gpm
 Est. Yield **60** gpm: Well water was ... ft. after ... hours pumping... gpm

4 TYPE OF BLANK CASING USED:
 1 Steel 3 RMP (SR) 5 Wrought iron 8 Concrete tile Casing Joints: Glued ... Clamped ...
 2 PVC 4 ABS 6 Asbestos-Cement 9 Other (specify below) Welded ...
 7 Fiberglass Threaded ...
 Blank casing dia... **5** in. to **120** ft. Dia... in. to ... ft. Dia... in. to ... ft.
 Casing height above land surface... **12** in., weight **2.8** lbs./ft. Wall thickness or gauge No... **Sch. 40**
 TYPE OF SCREEN OR PERFORATION MATERIAL:
 1 Steel 3 Stainless steel 5 Fiberglass 7 PVC 10 Asbestos-cement
 2 Brass 4 Galvanized steel 6 Concrete tile 8 RMP (SR) 11 Other (specify) ...
 9 ABS 12 None used (open hole)
 Screen or Perforation Openings Are:
 1 Continuous slot 3 Mill slot 5 Gauzed wrapped 8 Saw cut 11 None (open hole)
 2 Louvered shutter 4 Key punched 6 Wire wrapped 9 Drilled holes
 7 Torch cut 10 Other (specify) ...
 Screen-Perforation Dia... **5** in. to ... ft. Dia... in. to ... ft. Dia... in. to ... ft.
 Screen-Perforated Intervals: From **120** ft. to **140** ft., From ... ft. to ... ft.
 Gravel Pack Intervals: From **10** ft. to **140** ft., From ... ft. to ... ft.

5 GROUT MATERIAL: 1 Neat cement 2 Cement grout 3 Bentonite 4 Other ...
 Grouted Intervals: From... **0** ft. to **10** ft., From ... ft. to ... ft.
 What is the nearest source of possible contamination:
 1 Septic tank 4 Cess pool 7 Sewage lagoon 10 Fuel storage 14 Abandoned water well
 2 Sewer lines 5 Seepage pit 8 Feed yard 11 Fertilizer storage 15 Oil well/Gas well
 3 Lateral lines 6 Pit privy 9 Livestock pens 12 Insecticide storage 16 Other (specify below)
 13 Watertight sewer lines
 Direction from well... **East** How many feet... **60** ? Water Well Disinfected? Yes... **No**
 Was a chemical/bacteriological sample submitted to Department? Yes... **No** If yes, date sample was submitted ... month ... day ... year: Pump Installed? Yes... **No**
 If Yes: Pump Manufacturer's name... Model No... HP... Volts...
 Depth of Pump Intake ... ft. Pumps Capacity rated at ... gal./min.
 Type of pump: 1 Submersible 2 Turbine 3 Jet 4 Centrifugal 5 Reciprocating 6 Other

6 CONTRACTOR'S OR LANDOWNER'S CERTIFICATION: This water well was (1) constructed, (2) reconstructed, or (3) plugged under my jurisdiction and was completed on... **3** month... **13** day... **1981** year
 and this record is true to the best of my knowledge and belief. Kansas Water Well Contractor's License No... **186**
 This Water Well Record was completed on... **April** month... **24** day... **1981** year under the business name of **Kellys Water Well Service** by (signature) *Kelly Price*

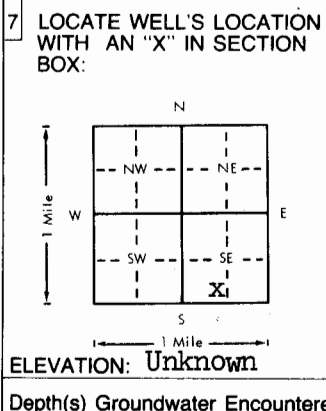

	FROM	TO	LITHOLOGIC LOG	FROM	TO	LITHOLOGIC LOG
	0	117	Clay			
	117	140	Sand and Gravel			

ELEVATION: **Unknown**
 Depth(s) Groundwater Encountered 1... **59** ft. 2... ft. 3... ft. 4... ft. (Use a second sheet if needed)