


1 LOCATION OF WATER WELL: County: <b>Kingman</b>	Fraction <b>C 1/4 SW 1/4 NE 1/4</b>	Section Number <b>12</b>	Township Number <b>T 27 S</b>	Range Number <b>R 10W E/W</b>
---	--	-----------------------------	----------------------------------	----------------------------------

Distance and direction from nearest town or city street address of well if located within city?  
**2 W, 1/2 S of Penalosa, Kansas**

2 WATER WELL OWNER: RR#, St. Address, Box # : City, State, ZIP Code :	<b>Big Springs Drilling</b> <b>Box 8287, Munger Station</b> <b>Wichita, Kansas 67208</b>	Justice No. <b>1</b> Board of Agriculture, Division of Water Resources Application Number:
---	--	--

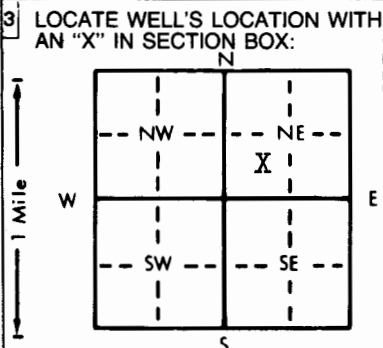

4 DEPTH OF COMPLETED WELL: <b>152</b> ft. ELEVATION: .....	Depth(s) Groundwater Encountered 1. .... ft. 2. .... ft. 3. .... ft.
WELL'S STATIC WATER LEVEL <b>66</b> ft. below land surface measured on mo/day/yr <b>2/23/79</b>	
Pump test data: Well water was ..... ft. after ..... hours pumping ..... gpm	
Est. Yield ..... gpm: Well water was ..... ft. after ..... hours pumping ..... gpm	
Bore Hole Diameter ..... in. to ..... ft., and ..... in. to ..... ft.	
WELL WATER <del>TYPE</del> USED AS:	
1 Domestic <b>WAS</b>	3 Feedlot
2 Irrigation	4 Industrial
5 Public water supply	6 <u>Oil field water supply</u>
8 Air conditioning	9 Dewatering
11 Injection well	12 Other (Specify below)
7 Lawn and garden only	10 Observation well
Was a chemical/bacteriological sample submitted to Department? Yes.....No.....; If yes, mo/day/yr sample was submitted	
Water Well Disinfected? Yes No	

5 TYPE OF BLANK CASING USED:	5 Wrought iron	8 Concrete tile
1 Steel	3 RMP (SR)	6 Asbestos-Cement
2 <u>PVC</u>	4 ABS	7 Fiberglass
9 Other (specify below)	CASING JOINTS: Glued ..... Clamped .....	
Blank casing diameter <b>5</b> in. to ..... ft., Dia ..... in. to ..... ft., Dia ..... in. to ..... ft.		Welded .....
Casing height above land surface <b>XX 3' below</b> in., weight ..... lbs./ft. Wall thickness or gauge No. ....		Threaded .....
TYPE OF SCREEN OR PERFORATION MATERIAL:		
1 Steel	3 Stainless steel	5 Fiberglass
2 Brass	4 Galvanized steel	6 Concrete tile
7 PVC	8 RMP (SR)	9 ABS
10 Asbestos-cement	11 Other (specify) .....	12 None used (open hole)
SCREEN OR PERFORATION OPENINGS ARE:		
1 Continuous slot	3 Mill slot	5 Gauzed wrapped
2 Louvered shutter	4 Key punched	6 Wire wrapped
8 Saw cut	9 Drilled holes	10 Other (specify) .....
11 None (open hole)		
SCREEN-PERFORATED INTERVALS: From ..... ft. to ..... ft., From ..... ft. to ..... ft.		
GRAVEL PACK INTERVALS: From ..... ft. to ..... ft., From ..... ft. to ..... ft.		

6 GROUT MATERIAL:	1 Neat cement	2 <u>Cement grout</u>
Grout Intervals: From <b>6</b> ft. to <b>3</b> ft., From ..... ft. to ..... ft., From ..... ft. to ..... ft.	3 Bentonite	4 Other .....
What is the nearest source of possible contamination:		
1 Septic tank	4 Lateral lines	7 Pit privy
2 Sewer lines	5 Cess pool	8 Sewage lagoon
3 Watertight sewer lines	6 Seepage pit	9 Feedyard
10 Livestock pens	11 Fuel storage	12 Fertilizer storage
14 Abandoned water well	15 <u>Oil well/Gas well</u>	16 Other (specify below)
13 Insecticide storage	How many feet? <b>65</b>	

FROM	TO	LITHOLOGIC LOG	FROM	TO	LITHOLOGIC LOG
152	110	Sand and Gravel			
110	6	Sandy Clay			
6	3	Cement			

7 CONTRACTOR'S OR LANDOWNER'S CERTIFICATION: This water well was (1) constructed, (2) reconstructed, or (3) plugged under my jurisdiction and was completed on (mo/day/year) ..... and this record is true to the best of my knowledge and belief. Kansas Water Well Contractor's License No. .... This Water Well Record was completed on (mo/day/yr) ..... under the business name of **Big Springs Drilling** by (signature) .....

INSTRUCTIONS: Use typewriter or ball point pen, **PLEASE PRESS FIRMLY** and **PRINT** clearly. Please fill in blanks, underline or circle the correct answers. Send top three copies to Kansas Department of Health and Environment, Division of Environment, Environmental Geology Section, Topeka, KS 66620. Send one to WATER WELL OWNER and retain one for your records.