

**WATER WELL RECORD Form WWC-5 KSA 82a-1212**


<b>1 LOCATION OF WATER WELL:</b> County: <u>Kingman</u>	Fraction <u>SW</u> ¼ <u>SE</u> ¼ <u>SE</u> ¼	Section Number <u>19</u>	Township Number <u>T 27 S</u>	Range Number <u>R 10W E/W</u>
--	---	-----------------------------	----------------------------------	----------------------------------

Distance and direction from nearest town or city street address of well if located within city?  
2 miles North Cunningham-1 ¼ West

**2 WATER WELL OWNER:** Texaco  
 RR#, St. Address, Box # : PO Box 127  
 City, State, ZIP Code : Cunningham, Ks. 67035

Board of Agriculture, Division of Water Resources  
Application Number:

**3 LOCATE WELL'S LOCATION WITH AN "X" IN SECTION BOX:**

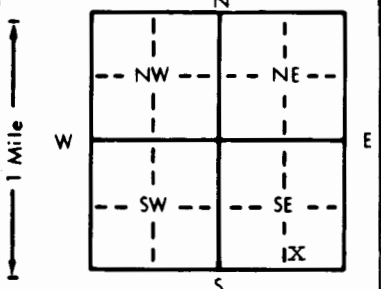

**4 DEPTH OF COMPLETED WELL:** 52 ft. ELEVATION: \_\_\_\_\_

Depth(s) Groundwater Encountered 1. \_\_\_\_\_ ft. 2. \_\_\_\_\_ ft. 3. \_\_\_\_\_ ft.

WELL'S STATIC WATER LEVEL 0 ft. below land surface measured on mo/day/yr 2-10-92

Pump test data: Well water was \_\_\_\_\_ ft. after \_\_\_\_\_ hours pumping \_\_\_\_\_ gpm

Est. Yield \_\_\_\_\_ gpm: Well water was \_\_\_\_\_ ft. after \_\_\_\_\_ hours pumping \_\_\_\_\_ gpm

Bore Hole Diameter 9 in. to \_\_\_\_\_ ft., and \_\_\_\_\_ in. to \_\_\_\_\_ ft.

WELL WATER TO BE USED AS:

<u>1</u> Domestic	<u>3</u> Feedlot	<u>6</u> Oil field water supply	<u>9</u> Dewatering	<u>11</u> Injection well
<u>2</u> Irrigation	<u>4</u> Industrial	<u>7</u> Lawn and garden only	<u>10</u> Monitoring well	<u>12</u> Other (Specify below)

Was a chemical/bacteriological sample submitted to Department? Yes \_\_\_\_\_ No X; If yes, mo/day/yr sample was submitted \_\_\_\_\_

Water Well Disinfected? Yes \_\_\_\_\_ No X

**5 TYPE OF BLANK CASING USED:**

<u>1</u> Steel	<u>3</u> RMP (SR)	<u>5</u> Wrought iron	<u>8</u> Concrete tile	CASING JOINTS: <u>X</u> Glued _____ Clamped _____
<u>2</u> PVC	<u>4</u> ABS	<u>6</u> Asbestos-Cement	<u>9</u> Other (specify below)	Welded _____
		<u>7</u> Fiberglass		Threaded _____

Blank casing diameter 5 in. to 42 ft., Dia \_\_\_\_\_ in. to \_\_\_\_\_ ft., Dia \_\_\_\_\_ in. to \_\_\_\_\_ ft.

Casing height above land surface 20 in., weight \_\_\_\_\_ lbs./ft. Wall thickness or gauge No. 25.8

TYPE OF SCREEN OR PERFORATION MATERIAL:

<u>1</u> Steel	<u>3</u> Stainless steel	<u>5</u> Fiberglass	<u>7</u> PVC	<u>10</u> Asbestos-cement
<u>2</u> Brass	<u>4</u> Galvanized steel	<u>6</u> Concrete tile	<u>8</u> RMP (SR)	<u>11</u> Other (specify)
			<u>9</u> ABS	<u>12</u> None used (open hole)

SCREEN OR PERFORATION OPENINGS ARE:

<u>1</u> Continuous slot	<u>3</u> Mill slot	<u>5</u> Gauzed wrapped	<u>8</u> Saw cut	<u>11</u> None (open hole)
<u>2</u> Louvered shutter	<u>4</u> Key punched	<u>6</u> Wire wrapped	<u>9</u> Drilled holes	
		<u>7</u> Torch cut	<u>10</u> Other (specify)	

SCREEN-PERFORATED INTERVALS: From 42 ft. to 52 ft., From \_\_\_\_\_ ft. to \_\_\_\_\_ ft.

GRAVEL PACK INTERVALS: From 52 ft. to 15 ft., From \_\_\_\_\_ ft. to \_\_\_\_\_ ft.

**6 GROUT MATERIAL:** 1 Neat cement      2 Cement grout      3 Bentonite      4 Other Hole Plug

Grout Intervals: From 15 ft. to 3 ft., From \_\_\_\_\_ ft. to \_\_\_\_\_ ft., From \_\_\_\_\_ ft. to \_\_\_\_\_ ft.

What is the nearest source of possible contamination:

<u>1</u> Septic tank	<u>4</u> Lateral lines	<u>7</u> Pit privy	<u>10</u> Livestock pens	<u>14</u> Abandoned water well
<u>2</u> Sewer lines	<u>5</u> Cess pool	<u>8</u> Sewage lagoon	<u>11</u> Fuel storage	<u>15</u> Oil well/Gas well
<u>3</u> Watertight sewer lines	<u>6</u> Seepage pit	<u>9</u> Feedyard	<u>12</u> Fertilizer storage	<u>16</u> Other (specify below)
			<u>13</u> Insecticide storage	<u>None</u>

Direction from well? \_\_\_\_\_ How many feet? \_\_\_\_\_

FROM	TO	LITHOLOGIC LOG	FROM	TO	PLUGGING INTERVALS
0	3	Top Soil			
3	6	Clay			
6	17	Sand & Gravel			
17	25	Clay			
25	35	Sand & Gravel			
35	40	Sand & Gravel w/ Clay			
40	52	Sand & Gravel			

**7 CONTRACTOR'S OR LANDOWNER'S CERTIFICATION:** This water well was (1) constructed, (2) reconstructed, or (3) plugged under my jurisdiction and was completed on (mo/day/year) 2-10-92 and this record is true to the best of my knowledge and belief. Kansas Water Well Contractor's License No. 134. This Water Well Record was completed on (mo/day/yr) 2-13-92 under the business name of Rosencrantz-Bemis by (signature) Dug Dodson