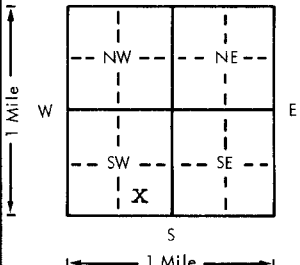


USE TYPEWRITER OR BALL POINT PEN-PRESS FIRMLY, PRINT CLEARLY.

WATER WELL RECORD  
KSA 82a-1201-1215

Kansas Department of Health and Environment-Division of Environment  
(Water well Contractors)  
Topeka, Kansas 66620

1. Location of well:	County <b>Kingman</b>	Fraction SW <del>20</del> 1/4 se 1/4 SW 1/4	Section number <b>20</b>	Township number T <b>27</b> S R	Range number <b>10</b> <del>W</del>
2. Distance and direction from nearest town or city: <del>2-1/2 mi N into field from Cunningham, Ks.</del> Street address of well location if in city: <b>2-N 1/2-E of Cunningham, Ks</b>			3. Owner of well: <b>Northern Natural Gas Co.</b> Box 178 Cunningham, Ks. 67035		
4. Locate with "X" in section below: Sketch map: 			6. Bore hole dia. <b>6 3/4</b> in. Completion date _____ Well depth <b>90</b> ft. <b>7-11-78</b>		
5. Type and color of material			7. <input type="checkbox"/> Cable tool <input checked="" type="checkbox"/> Rotary <input type="checkbox"/> Driven <input type="checkbox"/> Dug <input type="checkbox"/> Hollow rod <input type="checkbox"/> Jetted <input type="checkbox"/> Bored <input type="checkbox"/> Reverse rotary		
From To			8. Use: <input type="checkbox"/> Domestic <input type="checkbox"/> Public supply <input type="checkbox"/> Industry <input type="checkbox"/> Irrigation <input type="checkbox"/> Air conditioning <input type="checkbox"/> Stock <input type="checkbox"/> Lawn <input checked="" type="checkbox"/> Oil field water <input type="checkbox"/> Other		
sandy top soil			9. Casing: Material <b>pvc</b> Height: Above or <del>below</del> Threaded <input type="checkbox"/> Welded <input type="checkbox"/> Surface <b>18</b> in. RMP <input type="checkbox"/> PVC <input checked="" type="checkbox"/> Weight _____ lbs./ft. Dia. <b>4 1/2</b> in. to <b>90</b> ft. depth Wall thickness: inches or Dia. _____ in. to _____ ft. depth gage No. <b>237</b>		
fine sand			10. Screen: Manufacturer's name _____ <b>CertainTeed</b> Type <b>pvc</b> Dia. _____ Slot <del>xxx</del> <b>1/16</b> Length <b>20</b> Set between <b>70</b> ft. and <b>90</b> ft. _____ ft. and _____ ft. Gravel pack? <input checked="" type="checkbox"/> Size range of material <b>3/4 3/8</b>		
sand & gravel			11. Static water level: _____ mo./day/yr. <b>9</b> ft. below land surface Date <b>7-11-78</b>		
clay			12. Pumping level below land surfaces: <b>na</b> _____ ft. after _____ hrs. pumping _____ g.p.m. _____ ft. after _____ hrs. pumping _____ g.p.m. Estimated maximum yield _____ g.p.m.		
sand & gravel			13. Water sample submitted: _____ mo./day/yr. <input type="checkbox"/> Yes <input checked="" type="checkbox"/> No Date _____		
red bed			14. Well head completion: <input type="checkbox"/> Pitless adapter _____ Inches above grade		
			15. Well grouted? <input checked="" type="checkbox"/> With: <input checked="" type="checkbox"/> Neat cement <input type="checkbox"/> Bentonite <input type="checkbox"/> Concrete Depth: From <b>0</b> ft. to <b>10</b> ft.		
			16. Nearest source of possible contamination: ft. <b>50</b> Direction <b>nwe</b> Type <b>oilwell</b> Well disinfected upon completion? <input checked="" type="checkbox"/> Yes <input type="checkbox"/> No		
			17. Pump: <input checked="" type="checkbox"/> Not installed Manufacturer's name _____ Model number _____ HP _____ Volts _____ Length of drop pipe _____ ft. capacity _____ g.p.m. Type: <input type="checkbox"/> Submersible <input type="checkbox"/> Turbine <input type="checkbox"/> Jet <input type="checkbox"/> Reciprocating <input type="checkbox"/> Centrifugal <input type="checkbox"/> Other		
(Use a second sheet if needed)			20. Water well contractor's certification: This well was drilled under my jurisdiction and this report is true to the best of my knowledge and belief. <b>Rosencrantz-Bemis</b> <b>134</b> Business name License No. Address <b>Great Bend, Ks. 67530</b> Signed <b>Sandy K. Pope</b> Date <b>12-18-78</b> Authorized representative		
18. Elevation:	19. Remarks:				
Topography: <input type="checkbox"/> Hill <input type="checkbox"/> Slope <input type="checkbox"/> Upland <input checked="" type="checkbox"/> Valley					

27  
 10  
 20  
 SW  
 Sec  
 1/4  
 1/4  
 1/4  
 1/4  
 SW  
 Sec  
 W