


1 LOCATION OF WATER WELL: Fraction SW 1/4 NE 1/4 SE 1/4 Section Number 32 Township Number T 27 S Range Number R 10 EW

Distance and direction from nearest town or city street address of well if located within city?
 100 W. 4th St. mw-9

2 WATER WELL OWNER: CUNNINGHAM USD #332 Board of Agriculture, Division of Water Resources
 RR#, St. Address, Box #: Box 67 Application Number:
 City, State, ZIP Code: CUNNINGHAM, KS 67035

3 LOCATE WELL'S LOCATION WITH AN "X" IN SECTION BOX:

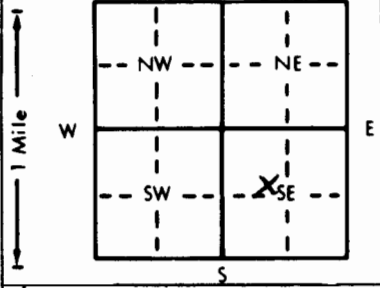

4 DEPTH OF COMPLETED WELL: 33.83 ft. ELEVATION: 1702

Depth(s) Groundwater Encountered 1. 26 ft. 2. - ft. 3. - ft.
 WELL'S STATIC WATER LEVEL 25.80 ft. below land surface measured on mo/day/yr 9-2-93
 Pump test data: Well water - ft. after - hours pumping - gpm
 Est. Yield - gpm: Well water was - ft. after - hours pumping - gpm
 Bore Hole Diameter 8 in. to 38.0 ft., and - in. to - ft.

WELL WATER TO BE USED AS:
 5 Public water supply 8 Air conditioning 11 Injection well
 1 Domestic 3 Feedlot 6 Oil field water supply 9 Dewatering 12 Other (Specify below)
 2 Irrigation 4 Industrial 7 Lawn and garden only 10 Monitoring well mw-9
 Was a chemical/bacteriological sample submitted to Department? Yes - No X; If yes, mo/day/yr sample was submitted
 Water Well Disinfected? Yes - No

5 TYPE OF BLANK CASING USED:
 1 Steel 3 RMP (SR) 5 Wrought iron 8 Concrete tile CASING JOINTS: Glued - Clamped -
 2 PVC 4 ABS 6 Asbestos-Cement 9 Other (specify below) Welded -
 7 Fiberglass Threaded X

Blank casing diameter 2 in. to 18.83 ft., Dia - in. to - ft., Dia - in. to - ft.
 Casing height above land surface -3.0 in., weight - lbs./ft. Wall thickness or gauge No. 40

TYPE OF SCREEN OR PERFORATION MATERIAL:
 1 Steel 3 Stainless steel 5 Fiberglass 8 RMP (SR) 10 Asbestos-cement
 2 Brass 4 Galvanized steel 6 Concrete tile 9 ABS 11 Other (specify) -
 12 None used (open hole)

SCREEN OR PERFORATION OPENINGS ARE:
 1 Continuous slot 3 Mill slot 5 Gauzed wrapped 8 Saw cut 11 None (open hole)
 2 Louvered shutter 4 Key punched 6 Wire wrapped 9 Drilled holes
 7 Torch cut 10 Other (specify) -

SCREEN-PERFORATED INTERVALS: From 18.83 ft. to 33.83 ft., From - ft. to - ft.
 From - ft. to - ft., From - ft. to - ft.
 GRAVEL PACK INTERVALS: From 16.83 ft. to 38.0 ft., From - ft. to - ft.
 From - ft. to - ft., From - ft. to - ft.

6 GROUT MATERIAL: 1 Neat cement 2 Cement grout 3 Bentonite 4 Other
 Grout Intervals: From 0 ft. to 16.83 ft., From - ft. to - ft., From - ft. to - ft.

What is the nearest source of possible contamination:
 1 Septic tank 4 Lateral lines 7 Pit privy 10 Livestock pens 14 Abandoned water well
 2 Sewer lines 5 Cess pool 8 Sewage lagoon 11 Fuel storage 15 Oil well/Gas well
 3 Watertight sewer lines 6 Seepage pit 9 Feedyard 12 Fertilizer storage 16 Other (specify below)
 13 Insecticide storage

Direction from well? West How many feet? 50

FROM	TO	LITHOLOGIC LOG	FROM	TO	PLUGGING INTERVALS
0	0.5'	CONCRETE			
0.5'	8.0'	BROWN SANDY SILTY CLAY			
8.0'	14.5'	GRAY Lt. BROWN SANDY SILTY CLAY			
14.5'	24.5'	BROWN MED-COARSE Grain SAND			
24.5'	38.0'	Gray Lt. Brown Silty CLAY			
	-TD-				

7 CONTRACTOR'S OR LANDOWNER'S CERTIFICATION: This water well was (1) constructed, (2) reconstructed, or (3) plugged under my jurisdiction and was completed on (mo/day/year) 9-2-94 and this record is true to the best of my knowledge and belief. Kansas Water Well Contractor's License No. 716 This Water Well Record was completed on (mo/day/yr) 2-9-94 under the business name of Terracon Consultants Inc by (signature) Richard D. Murphy