


02938504

1 LOCATION OF WATER WELL: Fraction SW 1/4 NE 1/4 SE 1/4 Section Number 32 Township Number T 27 S Range Number R 10 EW
 County: KINGMAN

Distance and direction from nearest town or city street address of well if located within city?
100 W. 4th St. mw-6

2 WATER WELL OWNER: CUNNINGHAM USD #332
 RR#, St. Address, Box #: Box 67 Board of Agriculture, Division of Water Resources
 City, State, ZIP Code: CUNNINGHAM, KS 67035 Application Number:

3 LOCATE WELL'S LOCATION WITH AN "X" IN SECTION BOX:

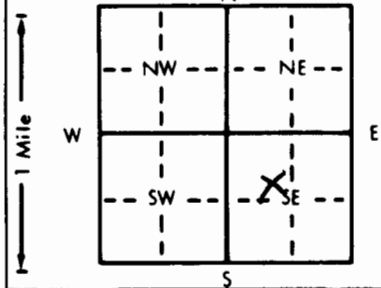

4 DEPTH OF COMPLETED WELL: 28.5 ft. ELEVATION: 1702

Depth(s) Groundwater Encountered 1. 22 ft. 2. - ft. 3. - ft.
 WELL'S STATIC WATER LEVEL 21.83 ft. below land surface measured on mo/day/yr 9-3-93
 Pump test data: Well water was - ft. after - hours pumping - gpm
 Est. Yield - gpm: Well water was - ft. after - hours pumping - gpm
 Bore Hole Diameter: 8 in. to 30.0 ft., and - in. to - ft.
 WELL WATER TO BE USED AS:
 5 Public water supply 8 Air conditioning 11 Injection well
 1 Domestic 3 Feedlot 6 Oil field water supply 9 Dewatering 12 Other (Specify below)
 2 Irrigation 4 Industrial 7 Lawn and garden only 10 Monitoring well mw-6
 Was a chemical/bacteriological sample submitted to Department? Yes - No X; If yes, mo/day/yr sample was submitted
 Water Well Disinfected? Yes - No X

5 TYPE OF BLANK CASING USED:
 1 Steel 3 RMP (SR) 5 Wrought iron 8 Concrete tile CASING JOINTS: Glued - Clamped -
2 VC 4 ABS 6 Asbestos-Cement 9 Other (specify below) Welded -
 7 Fiberglass Threaded X
 Blank casing diameter 2" in. to 18.5 ft., Dia. - in. to - ft., Dia. - in. to - ft.
 Casing height above land surface -3.0 in., weight - lbs./ft. Wall thickness or gauge No. 40

TYPE OF SCREEN OR PERFORATION MATERIAL:
 1 Steel 3 Stainless steel 5 Fiberglass 8 RMP (SR) 10 Asbestos-cement
 2 Brass 4 Galvanized steel 6 Concrete tile 9 ABS 11 Other (specify) -
 12 None used (open hole)

SCREEN OR PERFORATION OPENINGS ARE:
 1 Continuous slot 3 Mill slot 5 Gauzed wrapped 8 Saw cut 11 None (open hole)
 2 Louvered shutter 4 Key punched 6 Wire wrapped 9 Drilled holes
 7 Torch cut 10 Other (specify) -

SCREEN-PERFORATED INTERVALS: From 18.5 ft. to 28.5 ft., From - ft. to - ft.
 From - ft. to - ft., From - ft. to - ft.
 GRAVEL PACK INTERVALS: From 16.5 ft. to 30.0 ft., From - ft. to - ft.
 From 16.5 ft. to - ft., From - ft. to - ft.

6 GROUT MATERIAL: 1 Neat cement 2 Cement grout 3 Bentonite 4 Other -
 Grout Intervals: From 0 ft. to 16.5 ft., From - ft. to - ft., From - ft. to - ft.
 What is the nearest source of possible contamination:
 1 Septic tank 4 Lateral lines 7 Pit privy 10 Livestock pens 14 Abandoned water well
 2 Sewer lines 5 Cess pool 8 Sewage lagoon 11 Fuel storage 15 Oil well/Gas well
 3 Watertight sewer lines 6 Seepage pit 9 Feedyard 12 Fertilizer storage 16 Other (specify below)
 13 Insecticide storage

Direction from well? Southwest How many feet? 130

FROM	TO	LITHOLOGIC LOG	FROM	TO	PLUGGING INTERVALS
0.0	0.3'	TOPSOIL (GRASS)			
0.3'	7.5'	BROWN SANDY SILTY CLAY			
7.5'	23.5'	Grey Lt. BROWN SANDY SILTY CLAY			
23.5'	26.0'	BROWN MED COARSE GRAIN SAND			
26.0'	30.5'				
	-70-				

7 CONTRACTOR'S OR LANDOWNER'S CERTIFICATION: This water well was 1 constructed, (2) reconstructed, or (3) plugged under my jurisdiction and was completed on (mo/day/year) 9-1-93 and this record is true to the best of my knowledge and belief. Kansas Water Well Contractor's License No. 416 This Water Well Record was completed on (mo/day/yr) 9-9-94 under the business name of Terracon Consultants Inc by (signature) Richard D. Mayney