WATER WELL RECORD Form WWC-5 KSA 82a-1212

1 LOCATION OF WATER WELL:	Fraction	Section Number	Township Number	Range Number
County: KINGMAN	SW ¼ SE ¼ SW ¼	18	T 27 S	R 10 E/W

Distance and direction from nearest town or city street address of well if located within city?

2miles east, 2miles north, 1¼ miles east of Kingman,Kns.

2 WATER WELL OWNER: Charles R.Weems

RR#, St. Address, Box # : 501 SO Cheryl

City, State, ZIP Code : Wichita,Kans. 67209

Board of Agriculture, Division of Water Resources

Application Number:

3 LOCATE WELL'S LOCATION WITH AN "X" IN SECTION BOX:

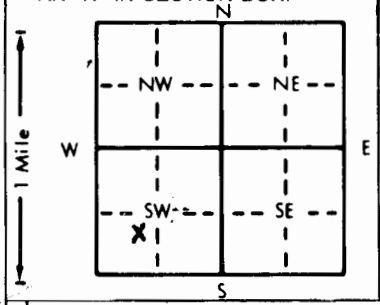

4 DEPTH OF COMPLETED WELL 40' ft. ELEVATION:

Depth(s) Groundwater Encountered 1. 9' ft. 2. ft. 3. ft.

WELL'S STATIC WATER LEVEL 7' ft. below land surface measured on mo/day/yr April 16 199

Pump test data: Well water was na ft. after hours pumping gpm

Est. Yield 18 gpm: Well water was ft. after hours pumping gpm

Bore Hole Diameter 8¼" in. to 40' ft., and in. to ft.

WELL WATER TO BE USED AS: 5 Public water supply 8 Air conditioning 11 Injection well

x 1 Domestic 3 Feedlot 6 Oil field water supply 9 Dewatering 12 Other (Specify below)

2 Irrigation 4 Industrial 7 Lawn and garden only 10 Monitoring well

Was a chemical/bacteriological sample submitted to Department? Yes No x; If yes, mo/day/yr sample was submitted

Water Well Disinfected? Yes x No

5 TYPE OF BLANK CASING USED: 5 Wrought iron 8 Concrete tile CASING JOINTS: Glued x Clamped

1 Steel 3 RMP (SR) 6 Asbestos-Cement 9 Other (specify below) Welded

xx 2 PVC 4 ABS 7 Fiberglass Threaded

Blank casing diameter 5" in. to 30' ft., Dia in. to ft., Dia in. to ft.

Casing height above land surface 12" in., weight 2.34 lbs./ft. Wall thickness or gauge No. 2.48

TYPE OF SCREEN OR PERFORATION MATERIAL:

xx 7 PVC 10 Asbestos-cement

1 Steel 3 Stainless steel 5 Fiberglass 8 RMP (SR) 11 Other (specify)

2 Brass 4 Galvanized steel 6 Concrete tile 9 ABS 12 None used (open hole)

SCREEN OR PERFORATION OPENINGS ARE:

xx 8 Saw cut 11 None (open hole)

1 Continuous slot 3 Mill slot 5 Gauzed wrapped 9 Drilled holes

2 Louvered shutter 4 Key punched 6 Wire wrapped 10 Other (specify)

7 Torch cut

SCREEN-PERFORATED INTERVALS: From 40' ft. to 30' ft., From ft. to ft.

From ft. to ft., From ft. to ft.

GRAVEL PACK INTERVALS: From ft. to ft., From ft. to ft.

From 40' ft. to 23' ft., From ft. to ft.

6 GROUT MATERIAL: 1 Neat cement 2 Cement grout xx 3 Bentonite 4 Other

Grout Intervals: From 23' ft. to 3' ft., From ft. to ft., From ft. to ft.

What is the nearest source of possible contamination:

xx 1 Septic tank 4 Lateral lines 7 Pit privy 10 Livestock pens 14 Abandoned water well

2 Sewer lines 5 Cess pool 8 Sewage lagoon 11 Fuel storage 15 Oil well/Gas well

3 Watertight sewer lines 6 Seepage pit 9 Feedyard 12 Fertilizer storage 16 Other (specify below)

13 Insecticide storage

Direction from well? East How many feet? 76'

FROM	TO	LITHOLOGIC LOG	FROM	TO	PLUGGING INTERVALS
0'	3'	Dark Top Soil.			
3'	6'	Dark Clay.			
6'	9'	Sandy Clay.			
9'	24'	Clay.			
24'	28'	Sandy Clay.			
28'	34'	Course Sand & Fine Gravel.			
34'	40'	Red Bed.			

7 CONTRACTOR'S OR LANDOWNER'S CERTIFICATION: This water well was (1) constructed, (2) reconstructed, or (3) plugged under my jurisdiction and was completed on (mo/day/year) April 16 1998 and this record is true to the best of my knowledge and belief. Kansas Water Well Contractor's License No. 112. This Water Well Record was completed on (mo/day/yr) April 21 1998 under the business name of WELLS DRILLING CO by (signature) Dal Wells

INSTRUCTIONS: Use typewriter or ball point pen. *PLEASE PRESS FIRMLY* and *PRINT* clearly. Please fill in blanks, underline or circle the correct answers. Send top three copies to Kansas Department of Health and Environment, Bureau of Water, Topeka, Kansas 66620-0001. Telephone: 913-296-5545. Send one to WATER WELL OWNER and retain one for your records.

OFFICE USE ONLY T R E/W SEC. ¼ ¼ ¼