


1 LOCATION OF WATER WELL: Fraction **SW 1/4 SE 1/4 NE 1/4** Section Number **26** Township Number **T 27 S** Range Number **R 10 W E/W**
 County: **Rego, Kingman**

Distance and direction from nearest town or city street address of well if located within city?
3 east 4 south of Turen

2 WATER WELL OWNER: **Allan Crotts**
 RR#, St. Address, Box #: **25808 B Oleet Rd** Board of Agriculture, Division of Water Resources
 City, State, ZIP Code: **Turen, Ks. 67583** Application Number:

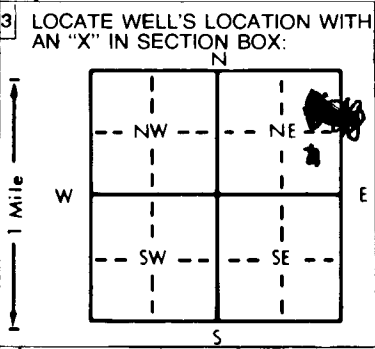

4 DEPTH OF COMPLETED WELL: **45** ft. ELEVATION:
 Depth(s) Groundwater Encountered 1. **20** ft. 2. ft. 3. ft.
 WELL'S STATIC WATER LEVEL **7** ft. below land surface measured on mo/day/yr **12-17-97**
 Pump test data: Well water was _____ ft. after _____ hours pumping _____ gpm
 Est. Yield **15** gpm: Well water was _____ ft. after _____ hours pumping _____ gpm
 Bore Hole Diameter **9** in. to **46** ft., and _____ in. to _____ ft.
 WELL WATER TO BE USED AS: 5 Public water supply 8 Air conditioning 11 Injection well
 1 Domestic 3 Feedlot 6 Oil field water supply 9 Dewatering 12 Other (Specify below)
 2 Irrigation 4 Industrial 7 Lawn and garden only 10 Monitoring well
 Was a chemical/bacteriological sample submitted to Department? Yes _____ No _____; If yes, mo/day/yr sample was submitted
 Water Well Disinfected? Yes _____ No _____

5 TYPE OF BLANK CASING USED: 5 Wrought iron 8 Concrete tile CASING JOINTS: Glued Clamped _____
 1 Steel 3 RMP (SR) 6 Asbestos-Cement 9 Other (specify below) Welded _____
 2 PVC 4 ABS 7 Fiberglass Threaded _____
 Blank casing diameter **5** in. to **22** ft., Dia _____ in. to _____ ft., Dia _____ in. to _____ ft.
 Casing height above land surface **17** in., weight _____ lbs./ft. Wall thickness or gauge No. **210**
 TYPE OF SCREEN OR PERFORATION MATERIAL: 7 PVC 10 Asbestos-cement
 1 Steel 3 Stainless steel 5 Fiberglass 8 RMP (SR) 11 Other (specify) _____
 2 Brass 4 Galvanized steel 6 Concrete tile 9 ABS 12 None used (open hole)
 SCREEN OR PERFORATION OPENINGS ARE: 5 Gauzed wrapped 8 Saw cut 11 None (open hole)
 1 Continuous slot 3 Mill slot 6 Wire wrapped 9 Drilled holes
 2 Louvered shutter 4 Key punched **22** 7 Torch cut **28** 10 Other (specify) _____
 SCREEN-PERFORATED INTERVALS: From _____ ft. to _____ ft., From _____ ft. to _____ ft.
 GRAVEL PACK INTERVALS: From **23** ft. to **46** ft., From _____ ft. to _____ ft.

6 GROUT MATERIAL: 1 Neat cement 23 2 Cement grout 3 Bentonite 4 Other _____
 Grout Intervals: From **3** ft. to _____ ft., From _____ ft. to _____ ft., From _____ ft. to _____ ft.
 What is the nearest source of possible contamination:
 1 Septic tank 4 Lateral lines 7 Pit privy 10 Livestock pens 14 Abandoned water well
 2 Sewer lines 5 Cess pool 8 Sewage lagoon 11 Fuel storage 15 Oil well/Gas well
 3 Watertight sewer lines 6 Seepage pit 9 Feedyard 12 Fertilizer storage 16 Other (specify below)
 13 Insecticide storage **100**
 Direction from well? **S** How many feet?

FROM	TO	LITHOLOGIC LOG	FROM	TO	PLUGGING INTERVALS
0	2	soil			
2	15	clay			
15	20	fine sand			
20	28	clean sand			
28	36	clay			
36	44	fine sand			
44	46	shale			

7 CONTRACTOR'S OR LANDOWNER'S CERTIFICATION: This water well was (1) constructed, (2) reconstructed, or (3) plugged under my jurisdiction and was completed on (mo/day/year) **12-17-97** and this record is true to the best of my knowledge and belief. Kansas Water Well Contractor's License No. **140** This Water Well Record was completed on (mo/day/yr) **12-31-97** under the business name of **Lynan Inc.** by (signature) *Allan Crotts*

INSTRUCTIONS: Use typewriter or ball point pen. PLEASE PRESS FIRMLY and PRINT clearly. Please fill in blanks, underline or circle the correct answers. Send top three copies to Kansas Department of Health and Environment, Bureau of Water, Topeka, Kansas 66620-0001. Telephone: 913-296-5545. Send one to WATER WELL OWNER and retain one for your records.

OFFICE USE ONLY T R EW SEC 1/4 1/4 1/4