


1 LOCATION OF WATER WELL: Fraction $\frac{1}{4}$ SW $\frac{1}{4}$ SW $\frac{1}{4}$ SW Section Number 25 Township Number 27 Range Number 10 EW

Distance and direction from nearest town or city street address of well if located within city?
 3 miles EAST of CUNNINGHAM 1 mile North 800 FT EAST 650 FT North to well

2 WATER WELL OWNER: PUTT BARNUM
 RR #, St. Address, Box #: 13952 NW 10 ST
 City, State, ZIP Code : CUNNINGHAM, KS 67035 Board of Agriculture, Division of Water Resources
 Application Number: _____

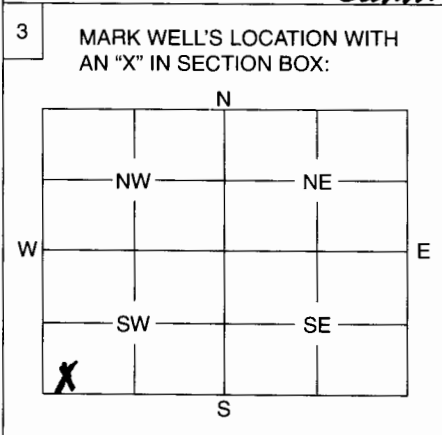

4 DEPTH OF WELL 35 ft.
 WELL'S STATIC WATER LEVEL 19 ft.
 WELL WAS USED AS:
 Domestic
 Irrigation
 Feedlot
 Industrial
 Public Water Supply
 Oil Field Water Supply
 Domestic (Lawn & Garden)
 Air Conditioning
 Dewatering
 Monitoring Well
 Injection Well
 Other
 Was a chemical / bacteriological sample submitted to Department? Yes No
 If yes, mo/day/yr sample was submitted
 Water Well Disinfected: Yes No

5 TYPE OF BLANK CASING USED:
 Steel
 PVC
 RMP (SR)
 ABS
 Wrought
 Asbestos-Cement
 Fiberglass
 Concrete Tile
 Other (Specify below)
 Blank casing diameter .. 6 1/2 .. in. Was casing pulled? Yes No
 Casing height above or below land surface 36 in. If yes, how much

6 GROUT PLUG MATERIAL: 1 Neat cement 2 Cement grout Bentonite Other CEMENT
 Grout Plug Intervals: From 35 ft. to 31 ft., From 31 ft. to 3 ft., From to ft.
 What is the nearest source of possible contamination:
 Septic tank
 Sewer lines
 Watertight sewer lines
 Lateral lines
 Cess pool
 Seepage pit
 Pit privy
 Sewage lagoon
 Feedyard
 Livestock pens
 Fuel storage
 Fertilizer storage
 Insecticide storage
 Abandoned water well
 Oil well/Gas well
 16 Other (specify below)
 Direction from well? EAST How many feet? 150 FT

FROM	TO	PLUGGING MATERIALS
35	31	Bentonite
31	3	Cement
3		Bottom of well pit

7 CONTRACTOR'S OF LANDOWNER'S CERTIFICATION: This water well was plugged under my jurisdiction and was completed on (mo/day/year) 3-20-18 and this record is true to the best of my knowledge and belief. Kansas Water Well Contractor's License No. 672 This Water Well Record was completed on (mo/day/year) 3-26-18 under the business name of CROWDIS WATER WELL S&P
 by (signature) [Signature]

INSTRUCTIONS: Use typewriter or ball point pen. Please press firmly and print clearly. Please fill in blanks, underline or circle the correct answers. Send top three copies to Kansas Department of Health and Environment, Bureau of Water, Geology Section, 1000 SW Jackson St., Ste. 420, Topeka, Kansas 66612-1367. Telephone: 785/296-5522. Send one to Water Well Owner and retain one for your records.