

WATER WELL RECORD Form WWC-5


Original Record Correction Change in Well Use

Division of Water Resources App. No.

Well ID

LOCATION OF WATER WELL: County: Kingman Fraction: 1/4 NE SW SE Section Number: 36 Township Number: T 27 S Range Number: R 10 E W

WELL OWNER: Last Name: Albers First: Steve Street or Rural Address where well is located (if unknown, distance and direction from nearest town or intersection): If at owner's address, check here:
 Business: _____ Address: 15140 SW 70th St 3 3/4 E. Cunningham
 City: Cunningham State: KS ZIP: 67035

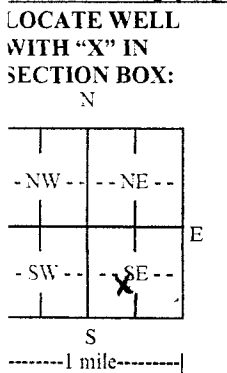

4 DEPTH OF COMPLETED WELL: 42 ft.
 Depth(s) Groundwater Encountered: 1) _____ ft.
 2) _____ ft. 3) _____ ft., or 4) Dry Well
WELL'S STATIC WATER LEVEL: 37 ft.
 below land surface, measured on (mo-day-yr) 8-15-19
 above land surface, measured on (mo-day-yr) _____
 Pump test data: Well water was _____ ft.
 after _____ hours pumping _____ gpm
 Well water was _____ ft.
 after _____ hours pumping _____ gpm
 Estimated Yield: 1.0 gpm
 Bore Hole Diameter: 10 in. to 42 ft. and _____ in. to _____ ft.

5 Latitude: _____ (decimal degrees)
Longitude: _____ (decimal degrees)
Horizontal Datum: WGS 84 NAD 83 NAD 27
Source for Latitude/Longitude:
 GPS (unit make/model: _____) (WAAS enabled? Yes No)
 Land Survey Topographic Map
 Online Mapper: _____
6 Elevation: _____ ft. Ground Level TOC
Source: Land Survey GPS Topographic Map Other _____

WELL WATER TO BE USED AS:

Domestic: Household Lawn & Garden Livestock Irrigation Feedlot Industrial

5. Public Water Supply: well ID _____
 6. Dewatering: how many wells? _____
 7. Aquifer Recharge: well ID _____
 8. Monitoring: well ID _____
 9. Environmental Remediation: well ID _____
 Air Sparge Soil Vapor Extraction
 Recovery Injection

10. Oil Field Water Supply: lease _____
 11. Test Hole: well ID _____
 Cased Uncased Geotechnical
 12. Geothermal: how many bores? _____
 a) Closed Loop Horizontal Vertical
 b) Open Loop Surface Discharge Inj. of Water
 13. Other (specify): _____

Is a chemical/bacteriological sample submitted to KDHE? Yes No If yes, date sample was submitted: _____
 Is the well disinfected? Yes No

TYPE OF CASING USED: Steel PVC Other _____ CASING JOINTS: Glued Clamped Welded Threaded
 Casing diameter: 5 in. to 42 ft., Diameter _____ in. to _____ ft., Diameter _____ in. to _____ ft.
 Casing height above land surface: 24 in. Weight 160 lbs./ft. Wall thickness or gauge No. _____

TYPE OF SCREEN OR PERFORATION MATERIAL:
 Steel Stainless Steel Fiberglass PVC Other (Specify) _____
 Brass Galvanized Steel Concrete tile None used (open hole)

SCREEN OR PERFORATION OPENINGS ARE:
 Continuous Slot Mill Slot Gauze Wrapped Torch Cut Drilled Holes Other (Specify) _____
 Louvered Shutter Key Punched Wire Wrapped Saw Cut None (Open Hole)

SCREEN-PERFORATED INTERVALS: From 20 ft. to 33 ft., From _____ ft. to _____ ft., From _____ ft. to _____ ft.
GRAVEL PACK INTERVALS: From 20 ft. to 42 ft., From _____ ft. to _____ ft., From _____ ft. to _____ ft.

ROUT MATERIAL: Neat cement Cement grout Bentonite Other _____
 Seal Intervals: From 0 ft. to 20 ft., From _____ ft. to _____ ft., From _____ ft. to _____ ft.

Closest source of possible contamination:
 Septic Tank Lateral Lines Pit Privy Livestock Pens Insecticide Storage
 Sewer Lines Cess Pool Sewage Lagoon Fuel Storage Abandoned Water Well
 Watertight Sewer Lines Seepage Pit Feedyard Fertilizer Storage Oil Well/Gas Well
 Other (Specify) _____
 Direction from well? NW Distance from well? 1500 ft.

FROM	TO	LITHOLOGIC LOG	FROM	TO	LITHO. LOG (cont.) or PLUGGING INTERVALS
0	1	Sandy Soil			
1	19	Red Silty Fine Sand			
19	32	Fine Silty Sand w/ Red Clay			
32	38	Red Clay			
38	42	White & grey Clay			
Notes:					

CONTRACTOR'S OR LANDOWNER'S CERTIFICATION: This water well was constructed, reconstructed, or plugged in my jurisdiction and was completed on (mo-day-year) 8-15-19 and this record is true to the best of my knowledge and belief. Kansas Water Well Contractor's License No. 190. This Water Well Record was completed on (mo-day-year) 8-29-19. Signature: [Signature]