


1 LOCATION OF WATER WELL: County: **Kingman** Fraction: **NE 1/4 NE 1/4 NW 1/4** Section Number: **31** Township Number: **T 27 S** Range Number: **R 10**

Distance and direction from nearest town or city street address of well if located within city?
North west Part of Kingman- 1802 Pine Ridge Sub Division

2 WATER WELL OWNER: **Mark Keeny**
 RR#, St. Address, Box #: **1802 Whetzel** Board of Agriculture, Division of Water Resources
 City, State, ZIP Code: **Kingman, Kans 67068** Application Number:

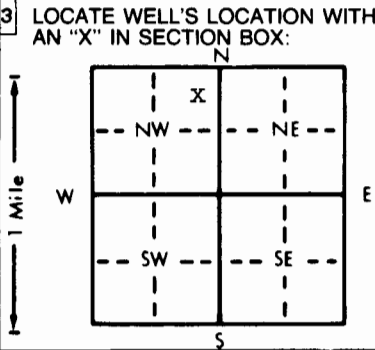

4 DEPTH OF COMPLETED WELL: **44'** ft. ELEVATION: ft.
 Depth(s) Groundwater Encountered 1. **17'** ft. 2. ft. 3. ft.
 WELL'S STATIC WATER LEVEL **16'** ft. below land surface measured on mo/day/yr **April 17-95**
 Pump test data: Well water was ft. after hours pumping gpm
 Est. Yield **15** gpm; Well water was **NA** ft. after hours pumping gpm
 Bore Hole Diameter **7.7/8"** in. to **44'** ft., and in. to ft.
 WELL WATER TO BE USED AS:
 Domestic 3 Feedlot 6 Oil field water supply 9 Dewatering 12 Other (Specify below)
 2 Irrigation 4 Industrial 7 Lawn and garden only 10 Monitoring well
 Was a chemical/bacteriological sample submitted to Department? Yes.....No.; If yes, mo/day/yr sample was submitted
 Water Well Disinfected? Yes No

5 TYPE OF BLANK CASING USED:
 1 Steel 3 RMP (SR) 5 Wrought iron 8 Concrete tile CASING JOINTS: Glued Clamped
 PVC 4 ABS 6 Asbestos-Cement 9 Other (specify below) Welded
 7 Fiberglass Threaded
 Blank casing diameter **5"** in. to **26'** ft., Dia in. to ft., Dia in. to ft.
 Casing height above land surface **14"** in., weight **160** lbs./ft. Wall thickness or gauge No. **Sdr 26**
 TYPE OF SCREEN OR PERFORATION MATERIAL:
 Steel 3 Stainless steel 5 Fiberglass PVC 10 Asbestos-cement
 2 Brass 4 Galvanized steel 6 Concrete tile 9 ABS 11 Other (specify)
 12 None used (open hole)
 SCREEN OR PERFORATION OPENINGS ARE:
 1 Continuous slot 3 Mill slot 5 Gauzed wrapped Saw cut 11 None (open hole)
 2 Louvered shutter 4 Key punched 6 Wire wrapped 9 Drilled holes
 7 Torch cut 10 Other (specify)
 SCREEN-PERFORATED INTERVALS: From **26'** ft. to **44'** ft., From ft. to ft.
 From ft. to ft., From ft. to ft.
 GRAVEL PACK INTERVALS: From ft. to ft., From ft. to ft.
 From **44'** ft. to **23'** ft., From ft. to ft.

6 GROUT MATERIAL: 1 Neat cement 2 Cement grout Bentonite 4 Other
 Grout intervals: From **23'** ft. to **2'** ft., From ft. to ft.
 What is the nearest source of possible contamination:
 1 Septic tank 4 Lateral lines 7 Pit privy 10 Livestock pens 14 Abandoned water well
 2 Sewer lines 5 Cess pool 8 Sewage lagoon 11 Fuel storage 15 Oil well/Gas well
 Watertight sewer lines 6 Seepage pit 9 Feedyard 12 Fertilizer storage 16 Other (specify below)
 13 Insecticide storage
 Direction from well? **West** How many feet? **App. 85'**

FROM	TO	LITHOLOGIC LOG	FROM	TO	PLUGGING INTERVALS
0'	4'	Top Soil.			
4'	5'	Brown Clay.			
5'	23'	Brown Sand.			
23'	26'	Sand W/ Clay strips.			
26'	32'	Course Sand & Fine Gravel.			
32'	33'	White Clay.			
33'	43'	Medium Course Sand.			
43'	44'	Red Bed.			

7 CONTRACTOR'S OR LANDOWNER'S CERTIFICATION: This water well was (1) constructed, (2) reconstructed, or (3) plugged under my jurisdiction and was completed on (mo/day/year) **April 17 - 95** and this record is true to the best of my knowledge and belief. Kansas Water Well Contractor's License No. **112** This Water Well Record was completed on (mo/day/yr) **May 12 - 95** under the business name of **Wells Drilling Co.** by (signature) **Dal Wells**

OFFICE USE ONLY