


1 LOCATION OF WATER WELL: County: Pratt Fraction: NW 1/4 SW 1/4 NW 1/4 Section Number: 11 Township Number: T 27 S Range Number: R 11 X8W

Distance and direction from nearest town or city street address of well if located within city?
3 Miles West, 5 Miles North Of Cunningham, Kans.

2 WATER WELL OWNER: Marvin Thomas
 RR#, St. Address, Box # : 388SE 70th Ave Board of Agriculture, Division of Water Resources
 City, State, ZIP Code : Pratt, Kns. 67124 Application Number:

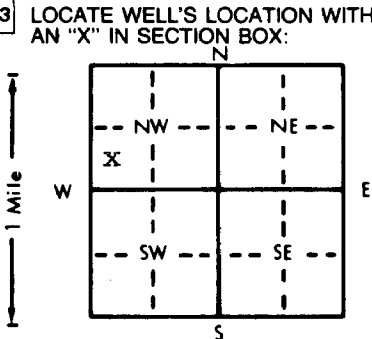

4 DEPTH OF COMPLETED WELL: 120' ft. ELEVATION: _____
 Depth(s) Groundwater Encountered 1. 42' ft. 2. _____ ft. 3. _____ ft.
 WELL'S STATIC WATER LEVEL 42' ft. below land surface measured on mo/day/yr April 27-99
 Pump test data: Well water was Na ft. after _____ hours pumping _____ gpm
 Est. Yield NA gpm: Well water was _____ ft. after _____ hours pumping _____ gpm
 Bore Hole Diameter: 63/4 in. to 120' ft., and _____ in. to _____ ft.
 WELL WATER TO BE USED AS:
 5 Public water supply 8 Air conditioning 11 Injection well
 1 Domestic 3 Feedlot 6 Oil field water supply 9 Dewatering 12 Other (Specify below)
 2 Irrigation XX 4 Industrial 7 Lawn and garden only 10 Monitoring well XXX
 Was a chemical/bacteriological sample submitted to Department? Yes _____ No XX; If yes, mo/day/yr sample was submitted _____
 Water Well Disinfected? Yes _____ No XX

5 TYPE OF BLANK CASING USED:
 1 Steel 3 RMP (SR) 5 Wrought iron 8 Concrete tile CASING JOINTS: Glued XX Clamped _____
 2 PVC XX 4 ABS 6 Asbestos-Cement 9 Other (specify below) Welded _____
 7 Fiberglass Threaded _____
 Blank casing diameter 3" in. to 115' ft., Dia _____ in. to _____ ft., Dia _____ in. to _____ ft.
 Casing height above land surface 18" in., weight 1.56 lbs./ft. Wall thickness or gauge No. 300
 TYPE OF SCREEN OR PERFORATION MATERIAL:
 1 Steel 3 Stainless steel 5 Fiberglass 7 PVC XX 10 Asbestos-cement
 2 Brass 4 Galvanized steel 6 Concrete tile 8 RMP (SR) 11 Other (specify) _____
 9 ABS 12 None used (open hole)
 SCREEN OR PERFORATION OPENINGS ARE:
 1 Continuous slot 3 Mill slot 5 Gauzed wrapped XX Saw cut 11 None (open hole)
 2 Louvered shutter 4 Key punched 6 Wire wrapped 9 Drilled holes
 7 Torch cut 10 Other (specify) _____
 SCREEN-PERFORATED INTERVALS: From 115' ft. to _____ ft., From _____ ft. to _____ ft.
 From _____ ft. to _____ ft., From _____ ft. to _____ ft.
 GRAVEL PACK INTERVALS: From 120' ft. to 112' ft., From _____ ft. to _____ ft.
 From _____ ft. to _____ ft., From _____ ft. to _____ ft.

6 GROUT MATERIAL: 1 Neat cement 2 Cement grout XX 3 Bentonite 4 Other _____
 Grout Intervals: From 112' ft. to 0' ft., From _____ ft. to _____ ft., From _____ ft. to _____ ft.
 What is the nearest source of possible contamination:
 1 Septic tank 4 Lateral lines 7 Pit privy XX Livestock pens 14 Abandoned water well
 2 Sewer lines 5 Cess pool 8 Sewage lagoon 11 Fuel storage 15 Oil well/Gas well
 3 Watertight sewer lines 6 Seepage pit 9 Feedyard 12 Fertilizer storage 16 Other (specify below)
 13 Insecticide storage
 Direction from well? South How many feet? APP. 1320'

FROM	TO	LITHOLOGIC LOG	FROM	TO	PLUGGING INTERVALS
0'	3'	Sandy Top Soil.			
3'	7'	Medium Fine Sand.			
7'	11'	Medium Course Sand.			
11'	28'	Clay.			
28'	37'	Clay W/ Sand Strips.			
37'	73'	Clay W/Sand Strips.			
37'	85'	Medium Course Sand.			
85'	117'	Course Sand & Gravel.			
117'	120'	Course Sand(Cemented).			

7 CONTRACTOR'S OR LANDOWNER'S CERTIFICATION: This water well was (1) constructed, (2) ~~reconstructed~~ or (3) plugged under my jurisdiction and was completed on (mo/day/year) April 27, 1999 and this record is true to the best of my knowledge and belief. Kansas Water Well Contractor's License No. 112 This Water Well Record was completed on (mo/day/yr) May 2, 1999 under the business name of Wells Drilling Co. by (signature) Sal Wells