


1 LOCATION OF WATER WELL: Fraction NW 1/4 SW 1/4 NW 1/4 Section Number 11 Township Number T 27 S Range Number R 11 EW  
 County: Pratt

Distance and direction from nearest town or city street address of well if located within city?  
From Lunningham, KS 3 m W + 5 1/2 m N.

2 WATER WELL OWNER: Marvin Thomas  
 RR#, St. Address, Box #: 388 SE 70th Ave Board of Agriculture, Division of Water Resources  
 City, State, ZIP Code: Pratt KS 67124 Application Number: 43,496

3 LOCATE WELL'S LOCATION WITH AN "X" IN SECTION BOX:

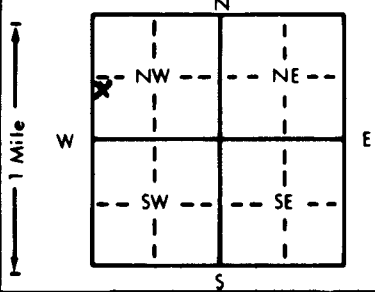

4 DEPTH OF COMPLETED WELL: 116 ft. ELEVATION: .....  
 Depth(s) Groundwater Encountered 1. 42' ft. 2. .... ft. 3. .... ft.  
 WELL'S STATIC WATER LEVEL 42' ft. below land surface measured on mo/day/yr 7-25-99  
 Pump test data: Well water was 72 ft. after 3 hours pumping 800 gpm  
 Est. Yield 800 gpm: Well water was ..... ft. after ..... hours pumping ..... gpm  
 Bore Hole Diameter: 30 in. to 116 ft., and ..... in. to ..... ft.  
 WELL WATER TO BE USED AS:  
 5 Public water supply 8 Air conditioning 11 Injection well  
 1 Domestic 3 Feedlot 6 Oil field water supply 9 Dewatering 12 Other (Specify below)  
Irrigation 4 Industrial 7 Lawn and garden only 10 Monitoring well  
 Was a chemical/bacteriological sample submitted to Department? Yes.....No X.....; If yes, mo/day/yr sample was submitted  
 Water Well Disinfected? Yes X No

5 TYPE OF BLANK CASING USED:  
 1 Steel 3 RMP (SR) 5 Wrought iron 8 Concrete tile CASING JOINTS: Glued X Clamped .....  
PVC 4 ABS 7 Fiberglass ..... Welded .....  
 Blank casing diameter 16 in. to 76 ft., Dia ..... in. to ..... ft., Dia ..... in. to ..... ft.  
 Casing height above land surface 12 in., weight 16 lbs./ft. Wall thickness or gauge No. 1/2"

TYPE OF SCREEN OR PERFORATION MATERIAL:  
 1 Steel 3 Stainless steel 5 Fiberglass 8 RMP (SR) 10 Asbestos-cement  
 2 Brass 4 Galvanized steel 6 Concrete tile 9 ABS 11 Other (specify) .....  
 12 None used (open hole)

SCREEN OR PERFORATION OPENINGS ARE:  
 1 Continuous slot 3 Mill slot 5 Gauzed wrapped 8 Saw cut 11 None (open hole)  
 2 Louvered shutter 4 Key punched 6 Wire wrapped 9 Drilled holes  
 7 Torch cut 10 Other (specify) .....

SCREEN-PERFORATED INTERVALS: From 76 ft. to 116 ft., From ..... ft. to ..... ft.  
 GRAVEL PACK INTERVALS: From 40 ft. to 116 ft., From ..... ft. to ..... ft.

6 GROUT MATERIAL: 1 Neat cement 2 Cement grout 3 Bentonite 4 Other .....  
 Grout intervals: From 3 ft. to 40 ft., From ..... ft. to ..... ft.

What is the nearest source of possible contamination:  
 1 Septic tank 4 Lateral lines 7 Pit privy 10 Livestock pens 14 Abandoned water well  
 2 Sewer lines 5 Cess pool 8 Sewage lagoon 11 Fuel storage 15 Oil well/Gas well  
 3 Watertight sewer lines 6 Seepage pit 9 Feedyard 12 Fertilizer storage 16 Other (specify below)  
Open Field

Direction from well? How many feet?

FROM	TO	LITHOLOGIC LOG	FROM	TO	PLUGGING INTERVALS
0	7	Sandy Topsoil			
7	11	Med Course Sand			
11	72	Clay w/ Cemented Sand Strips			
72	75	Fine Gravel			
75	116	Med Course Gravel			
116		Cemented Sand			

7 CONTRACTOR'S OR LANDOWNER'S CERTIFICATION: This water well was (1) constructed, (2) reconstructed, or (3) plugged under my jurisdiction and was completed on (mo/day/year) 7-20-99 and this record is true to the best of my knowledge and belief. Kansas Water Well Contractor's License No. 238 This Water Well Record was completed on (mo/day/yr) 8-7-99 under the business name of Weninger Irrigation by (signature) [Signature]