


1 LOCATION OF WATER WELL: Pratt	FRACTION SE 1/4 NW 1/4 SE 1/4	Section Number 10	Township Number T 27 S	Range Number R 11W E/W
---	---	-----------------------------	----------------------------------	----------------------------------

Distance and direction from nearest town or city street address of well if located within city?
4 miles S, 2 5/8 m. E., 1/4 m. N. into field Preston, Kansas

WATER WELL OWNER: HUFF, Dennis	Board of Agriculture, Division of Water Resource
RR#, ST. ADDRESS, BOX #: 50506 NE 130th Ave	Application Number: 43,586
CITY, STATE, ZIP CODE: Preston, Kansas	67569

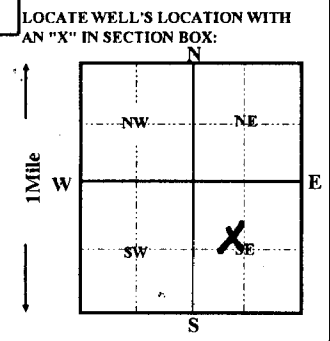

4 DEPTH OF COMPLETED WELL	125	ft.	ELEVATION:					
Depth(s) groundwater Encountered	1	ft.	2	ft.	3	ft.	ft.	ft.
WELL'S STATIC WATER LEVEL	41	FT. BELOW LAND SURFACE MEASURED ON	06/21/2000					
Pump test data:	Well water was	66	ft. after	1	hours pumping	800	gpm	
Est. Yield	gpm:	Well water was	ft. after	hours pumping	gpm			
Bore Hole Diameter	30	in. to	125	ft. and	in. to	ft.		
WELL WATER TO BE USED AS:	5 Public water supply		8 Air conditioning		11 Injection well			
	1 Domestic		3 Feedlot		6 Oil field water supply			
	2 Irrigation		4 Industrial		7 Lawn and garden only			
			9 Dewatering		10 Monitoring well			
Was a chemical/bacteriological sample submitted to Department? Yes <input type="checkbox"/> No <input checked="" type="checkbox"/> ; If yes, mo/day/yr sample was submitted								
Water Well Disinfected? Yes <input checked="" type="checkbox"/> No <input type="checkbox"/>								

5 TYPE OF CASING USED:	1 Steel	3 RMP (SR)	2 PVC	4 ABS	5 Wrought iron	8 Concrete tile	CASING JOINTS:	Glued <input checked="" type="checkbox"/>	Clamped
					6 Asbestos-Cement	9 Other (Specify below)		Welded	
					7 Fiberglass	SDR-26		Threaded	
Blank casing Diameter	16	in. to	75	ft., Dia	in. to	ft., Dia	in. to	ft.	
Casing height above land surface	12	in.,	weight	19.750	lbs. / ft.	Wall thickness or gauge No.	.616		
TYPE OF SCREEN OR PERFORATION MATERIAL:									
	1 Steel	3 Stainless Steel	5 Fiberglass	8 RMP (SR)	7 PVC	10 Asbestos-cement	11 other (specify)		
	2 Brass	4 Galvanized steel	6 Concrete tile	9 ABS	8 Saw cut	11 None used (open hole)			
SCREEN OR PERFORATION OPENING ARE:									
	1 Continous slot	3 Mill slot	6 Wire wrapped	7 Torch cut	9 Drilled holes	10 Other (specify)			
	2 Louvered shutter	4 Key punched							
SCREEN-PERFORATION INTERVALS:									
	from	75	ft. to	115	ft., From	ft. to	ft.		
		from	120	ft. to	125	ft., From	ft. to	ft.	
GRAVEL PACK INTERVALS:									
	from		ft. to		ft., From	ft. to	ft.		
	from	20	ft. to	125	ft., From	ft. to	ft.		

6 GROUT MATERIAL:	1 Neat cement	2 Cement grout	3 Bentonite	4 Other	bentonite hole plug
Grout Intervals: From	0	ft. to	20	ft. From	ft. to
What is the nearest source of possible contamination:					
	1 Septic tank	4 Lateral lines	7 Pit privy	10 Livestock pens	14 Abandon water well
	2 Sewer lines	5 Cess pool	8 Sewage lagoon	11 Fuel storage	15 Oil well/Gas well
	3 Watertight sewer lines	6 Seepage pit	9 Feedyard	12 Fertilizer storage	16 Other (specify below)
					13 Insecticide storage
					None Apparent
Direction from well?				How many feet?	

FROM	TO	LITHOLOGIC LOG	FROM	TO	How many feet?
0	2	soil	120	125	
2	8	brown clay			
8	38	very fine to coarse sand and gravel			
38	50	tan clay			
50	55	fine to coarse sand and gravel			
55	70	white and tan clay			
70	95	fine to coarse sand & fine to medium gravel with light clay stringers			
95	105	gray and blue clay			
105	115	fine to coarse sand to fine gravel			
115	120	gray clay			

7 CONTRACTOR'S OR LANDOWNER'S CERTIFICATION: This water well was (1) constructed, (2) reconstructed, or (3) plugged under my jurisdiction and was completed on (mo/day/year) 06/21/00 and this record is true to the best of my knowledge and belief. Kansas Water Well Contractor's License No. 236 This Water Well Record was completed on (mo/day/yr) 06/26/00	
Under the business name of Harp Well & Pump Service, Inc by (signature)	<i>Todd S. Harp</i>