


1 LOCATION OF WATER WELL: Fraction NW 1/4 SE 1/4 NW 1/4 Section Number 25 Township Number 27 Range Number 11 W
 County: PRATT

Distance and direction from nearest town or city street address of well if located within city?
2 mi W, 2 mi N, 1 mi W of CUNNINGHAM, KS.

2 WATER WELL OWNER: NORTHERN NATURAL GAS CO.
 RR #, St. Address, Box #: P.O. BOX 178 Board of Agriculture, Division of Water Resources
 City, State, ZIP Code: CUNNINGHAM, KS 67035 Application Number: _____

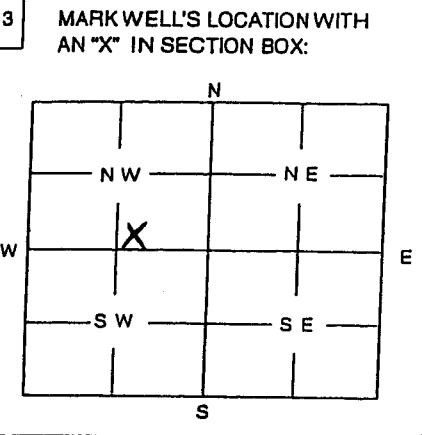

4 DEPTH OF WELL 10 ft
 WELL'S STATIC WATER LEVEL 6 ft
 WELL WAS USED AS:
 1 Domestic 5 Public Water Supply 9 Dewatering
 2 Irrigation 6 Oil Field Water Supply 10 Monitoring Well
 3 Feedlot 7 Domestic (Lawn & Garden) 11 Injection Well
 4 Industrial 8 Air Conditioning 12 Other

Was a chemical / bacteriological sample submitted to Department? Yes No
 If yes, mo/day/yr sample was submitted

Water Well Disinfected: Yes No

5 TYPE OF BLANK CASING USED:
 1 Steel 3 RMP (SR) 5 Wrought 7 Fiberglass 9 Other (Specify below)
 2 PVC 4 ABS 6 Asbestos-Cement 8 Concrete Tile

Blank casing diameter: 2 in. Was casing pulled? Yes No If yes, how much 10'
 Casing height above or below land surface in.

6 GROUT PLUG MATERIAL: 1 Neat cement 2 Cement grout 3 Bentonite 4 Other NATIVE CLAY
 Grout Plug Intervals: From 1.5 ft. to 6 ft., From 0 ft. to 1.5 ft., From to ft.

What is the nearest source of possible contamination:
 1 Septic tank 6 Seepage pit 11 Fuel storage 16 Other (specify below) BRINE PIPELINE
 2 Sewer lines 7 Pit privy 12 Fertilizer storage
 3 Watertight sewer lines 8 Sewage lagoon 13 Insecticide storage
 4 Lateral lines 9 Feedyard 14 Abandoned water well
 5 Cess Pool 10 Livestock pens 15 Oil well/Gas well

Direction from well? S How many feet? 250'

FROM	TO	PLUGGING MATERIALS
0	1.5	NATIVE CLAY 8"
1.5	6	BENTONITE 8"

PULLED CASING, DRILLED OUT 8" BOREHOLE TO 6', PLUGGED BACK TO SURFACE.

MW11

7 CONTRACTOR'S OR LANDOWNER'S CERTIFICATION: This water well was plugged under my jurisdiction and was completed on (mo/day/year) 6/27/2003 and this record is true to the best of my knowledge and belief. Kansas Water Well Contractor's License No. 527 This Water Well Record was completed on (mo/day/year) 9/5/03 under the business name of GEOSCORE INC.
 by (signature) [Signature]

INSTRUCTIONS: Use typewriter or ball point pen. Please press firmly and print clearly. Please fill in blanks, underline or circle the correct answers. Send top three copies to Kansas Department of Health and Environment, Bureau of Water, Topeka, Kansas 66620-0001. Telephone: 785/296-3565. Send one to Water Well Owner and retain one for your records.