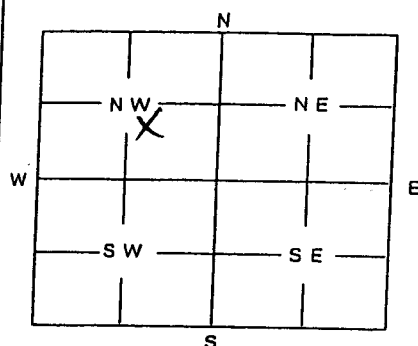


1	LOCATION OF WATER WELL:	Fraction	Section Number	Township Number	Range Number
	County: <u>PRATT</u>	<u>NW 1/4 SE 1/4 NW 1/4</u>	<u>25</u>	<u>27</u>	<u>11 W</u>

Distance and direction from nearest town or city street address of well if located within city?

2 MI W, 2 MI N, 1 MI W OF CUNNINGHAM, KS.2 WATER WELL OWNER: NORTHERN NATURAL GAS CO.RR #, St. Address, Box #: P.O. BOX 178City, State, ZIP Code : CUNNINGHAM, KS. 67035Board of Agriculture, Division of Water Resources  
Application Number:

3 MARK WELL'S LOCATION WITH AN "X" IN SECTION BOX:

4 DEPTH OF WELL ..... 10 ..... ftWELL'S STATIC WATER LEVEL ..... 5 ..... ft.

WELL WAS USED AS:

- 1 Domestic
- 2 Irrigation
- 3 Feedlot
- 4 Industrial

- 5 Public Water Supply
- 6 Oil Field Water Supply
- 7 Domestic (Lawn & Garden)
- 8 Air Conditioning

- 9 Dewatering
- 10 Monitoring Well
- 11 Injection Well
- 12 Other .....

Was a chemical / bacteriological sample submitted to Department? Yes ..... No ☒ ✓  
If yes, mo/day/yr sample was submitted .....Water Well Disinfected: Yes ..... No ☒ ✓

5 TYPE OF BLANK CASING USED:

- 1 Steel
- 2 PVC
- 3 RMP (SR)
- 4 ABS
- 5 Wrought
- 6 Asbestos-Cement
- 7 Fiberglass
- 8 Concrete Tile
- 9 Other (Specify below)

Blank casing diameter ..... 2 ..... in. Was casing pulled? Yes ☒ ✓ No ..... If yes, how much 10'  
Casing height above or below land surface .....6 GROUT PLUG MATERIAL: 1 Neat cement 2 Cement grout 3 Bentonite 4 Other NATIVE CLAY  
Grout Plug Intervals: From 1.5 ft. to 6 ft., From 0 ft. to 1.5 ft., From ..... to ..... ft.

What is the nearest source of possible contamination:

- 1 Septic tank
- 2 Sewer lines
- 3 Watertight sewer lines
- 4 Lateral lines
- 5 Cess Pool
- 6 Seepage pit
- 7 Pit privy
- 8 Sewage lagoon
- 9 Feedyard
- 10 Livestock pens
- 11 Fuel storage
- 12 Fertilizer storage
- 13 Insecticide storage
- 14 Abandoned water well
- 15 Oil well/Gas well

16 Other (specify below)  
BRINE PIPELINEDirection from well? SE How many feet? 180'

FROM	TO	PLUGGING MATERIALS
0	1.5	NATIVE CLAY 8"
1.5	6	BENTONITE 8"

PULLED CASING, DRILLED OUT 8"  
BOREHOLE TO 6', PLUGGED BACK  
TO SURFACE.

MW 12

7 CONTRACTOR'S OR LANDOWNER'S CERTIFICATION: This water well was plugged under my jurisdiction and was completed on (mo/day/year) 8/27/03 and this record is true to the best of my knowledge and belief. Kansas Water Well Contractor's License No. 527 This Water Well Record was completed on (mo/day/year) 9/5/03 under the business name of GEOCORE INC.  
by (signature) [Signature]

INSTRUCTIONS: Use typewriter or ball point pen. Please press firmly and print clearly. Please fill in blanks, underline or circle the correct answers. Send top three copies to Kansas Department of Health and Environment, Bureau of Water, Topeka, Kansas 66620-0001. Telephone: 785/296-3565. Send one to Water Well Owner and retain one for your records.