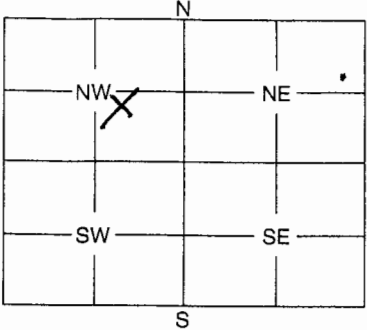


1	LOCATION OF WATER WELL:	Fraction	Section Number	Township Number	Range Number																											
	County: <u>Pratt</u>	<u>NW 1/4 SE 1/4 NW 1/4</u>	<u>25</u>	<u>27</u>	<u>11</u> E/W																											
Distance and direction from nearest town or city street address of well if located within city? <u>2 mi. W, 2 mi. N, 1 mi. W of Cunningham</u>																																
2	WATER WELL OWNER: <u>Northern Natural Gas Company</u>																															
	RR #, St. Address, Box #: <u>P.O. Box 178</u>		Board of Agriculture, Division of Water Resources																													
	City, State, ZIP Code: <u>Cunningham, KS 67035</u>		Application Number:																													
3	MARK WELL'S LOCATION WITH AN "X" IN SECTION BOX: <div style="text-align: center;">  </div>																															
4																																
DEPTH OF WELL <u>13</u> ft. WELL'S STATIC WATER LEVEL <u>6.5</u> ft. WELL WAS USED AS: <div style="display: flex; justify-content: space-between;"> <div> 1 Domestic 2 Irrigation 3 Feedlot 4 Industrial </div> <div> 5 Public Water Supply 6 Oil Field Water Supply 7 Domestic (Lawn & Garden) 8 Air Conditioning </div> <div> 9 Dewatering 10 Monitoring Well 11 Injection Well 12 Other </div> </div>																																
Was a chemical / bacteriological sample submitted to Department? Yes No <input checked="" type="checkbox"/> If yes, mo/day/yr sample was submitted Water Well Disinfected: Yes No <input checked="" type="checkbox"/>																																
5	TYPE OF BLANK CASING USED:																															
	1 Steel 3 RMP (SR) 5 Wrought 7 Fiberglass 9 Other (Specify below) ② PVC 4 ABS 6 Asbestos-Cement 8 Concrete Tile																															
	Blank casing diameter <u>2</u> in. Was casing pulled? Yes <input checked="" type="checkbox"/> No If yes, how much <u>13</u> in. Casing height above or below land surface <u>n/a</u> in.																															
6	GROUT PLUG MATERIAL: 1 Neat cement 2 Cement grout ③ Bentonite 4 Other																															
	Grout Plug Intervals: From <u>0</u> ft. to <u>13</u> ft., From ft. to ft., From ft. to ft.																															
What is the nearest source of possible contamination:																																
<div style="display: flex; justify-content: space-between;"> <div> 1 Septic tank 2 Sewer lines 3 Watertight sewer lines 4 Lateral lines 5 Cess pool </div> <div> 6 Seepage pit 7 Pit privy 8 Sewage lagoon 9 Feedyard 10 Livestock pens </div> <div> 11 Fuel storage 12 Fertilizer storage 13 Insecticide storage 14 Abandoned water well 15 Oil well/Gas well </div> <div> 16 Other (specify below) <u>Brine pipeline</u> </div> </div>																																
Direction from well? <u>N</u> How many feet? <u>60</u>																																
<table border="1" style="width:100%; border-collapse: collapse;"> <thead> <tr> <th style="width:10%;">FROM</th> <th style="width:10%;">TO</th> <th style="width:80%;">PLUGGING MATERIALS</th> </tr> </thead> <tbody> <tr> <td><u>0</u></td> <td><u>6</u></td> <td><u>Bentonite (8")</u></td> </tr> <tr> <td><u>6</u></td> <td><u>13</u></td> <td><u>Bentonite (2")</u></td> </tr> <tr><td> </td><td> </td><td> </td></tr> <tr><td> </td><td> </td><td> </td></tr> <tr><td> </td><td> </td><td> </td></tr> <tr><td> </td><td> </td><td> </td></tr> <tr><td> </td><td> </td><td> </td></tr> <tr><td> </td><td> </td><td> </td></tr>
7	CONTRACTOR'S OR LANDOWNER'S CERTIFICATION: This water well was plugged under my jurisdiction and was completed on (mo/day/year) <u>10/18/2004</u> and this record is true to the best of my knowledge and belief. Kansas Water Well Contractor's License No. <u>527</u> This Water Well Record was completed on (mo/day/year) <u>10/19/2004</u> under the business name of <u>GeoCore Inc.</u> by (signature) <u>Dan Robb</u>																															

RECEIVED

OCT 22 2004

BUREAU OF WATER

GeoCore #213