


1 LOCATION OF WATER WELL: Fraction SW 1/4 SE 1/4 NW 1/4 Section Number 25 Township Number 27 Range Number 11 E/W

Distance and direction from nearest town or city street address of well if located within city?  
2 mi. W, 2 mi. N, 1 mi. W of Cunningham

2 WATER WELL OWNER: Northern Natural Gas Company  
 RR #, St. Address, Box #: PO Box 178  
 City, State, ZIP Code: Cunningham, KS 67035 Board of Agriculture, Division of Water Resources  
 Application Number:

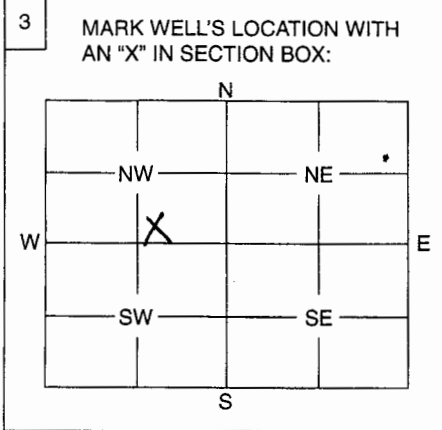

4 DEPTH OF WELL 12.9 ft.  
 WELL'S STATIC WATER LEVEL 6.5 ft.  
 WELL WAS USED AS:  
 1 Domestic 5 Public Water Supply 9 Dewatering  
 2 Irrigation 6 Oil Field Water Supply  10 Monitoring Well  
 3 Feedlot 7 Domestic (Lawn & Garden) 11 Injection Well  
 4 Industrial 8 Air Conditioning 12 Other .....

Was a chemical / bacteriological sample submitted to Department? Yes ..... No   
 If yes, mo/day/yr sample was submitted .....

Water Well Disinfected: Yes ..... No

5 TYPE OF BLANK CASING USED:  
 1 Steel 3 RMP (SR) 5 Wrought 7 Fiberglass 9 Other (Specify below)  
 2 PVC 4 ABS 6 Asbestos-Cement 8 Concrete Tile .....

Blank casing diameter 2 in. Was casing pulled? Yes  No ..... If yes, how much 12.9  
 Casing height above or below land surface n/a in.

6 GROUT PLUG MATERIAL: 1 Neat cement 2 Cement grout  3 Bentonite 4 Other .....

Grout Plug Intervals: From 0 ft. to 12.9 ft., From ..... ft. to ..... ft., From ..... to ..... ft.

What is the nearest source of possible contamination:  
 1 Septic tank 6 Seepage pit 11 Fuel storage  16 Other (specify below) Blaine Pipeline  
 2 Sewer lines 7 Pit privy 12 Fertilizer storage  
 3 Watertight sewer lines 8 Sewage lagoon 13 Insecticide storage  
 4 Lateral lines 9 Feedyard 14 Abandoned water well  
 5 Cess pool 10 Livestock pens 15 Oil well/Gas well

Direction from well? N How many feet? 300

FROM	TO	PLUGGING MATERIALS
<u>0</u>	<u>6</u>	<u>Bentonite (8")</u>
<u>6</u>	<u>12.9</u>	<u>Bentonite (2")</u>

MW2 RECEIVED  
 OCT 22 2004  
 BUREAU OF WATER  
 GeoCore #213

7 CONTRACTOR'S OF LANDOWNER'S CERTIFICATION: This water well was plugged under my jurisdiction and was completed on (mo/day/year) 10/18/2004 and this record is true to the best of my knowledge and belief. Kansas Water Well Contractor's License No. 527 This Water Well Record was completed on (mo/day/year) 10/19/2004 under the business name of GeoCore Inc. by (signature) Don Relf

INSTRUCTIONS: Use typewriter or ball point pen. Please press firmly and print clearly. Please fill in blanks, underline or circle the correct answers. Send top three copies to Kansas Department of Health and Environment, Bureau of Water, Geology Section, 1000 SW Jackson St., Ste. 420, Topeka, Kansas 66612-1367. Telephone: 785/296-5522. Send one to Water Well Owner and retain one for your records.