


1 LOCATION OF WATER WELL: Fraction SW 1/4 SE 1/4 NW 1/4 Section Number 25 Township Number 27 Range Number 11 EW

County: Pratt

Distance and direction from nearest town or city street address of well if located within city?
2 mi. W, 2 mi. N, 1 mi. W of Cunningham

2 WATER WELL OWNER: Northern Natural Gas Company
 RR #, St. Address, Box #: PO Box 178
 City, State, ZIP Code: Cunningham, KS 67035 Board of Agriculture, Division of Water Resources
 Application Number:

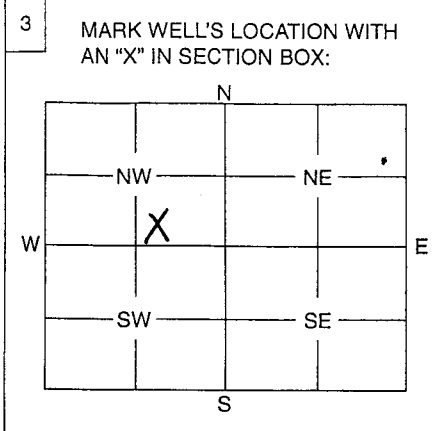

4 DEPTH OF WELL 12.8 ft.
 WELL'S STATIC WATER LEVEL 6.5 ft.
 WELL WAS USED AS:
 1 Domestic 5 Public Water Supply 9 Dewatering
 2 Irrigation 6 Oil Field Water Supply 10 Monitoring Well
 3 Feedlot 7 Domestic (Lawn & Garden) 11 Injection Well
 4 Industrial 8 Air Conditioning 12 Other

Was a chemical / bacteriological sample submitted to Department? Yes No
 If yes, mo/day/yr sample was submitted

Water Well Disinfected: Yes No

5 TYPE OF BLANK CASING USED:
 1 Steel 3 RMP (SR) 5 Wrought 7 Fiberglass 9 Other (Specify below)
 2 PVC 4 ABS 6 Asbestos-Cement 8 Concrete Tile

Blank casing diameter 2 in. Was casing pulled? Yes No If yes, how much 12.8
 Casing height above or below land surface n/a

6 GROUT PLUG MATERIAL: 1 Neat cement 2 Cement grout 3 Bentonite 4 Other

Grout Plug Intervals: From 0 ft. to 12.8 ft., From ft. to ft., From to ft.

What is the nearest source of possible contamination:
 1 Septic tank 6 Seepage pit 11 Fuel storage 16 Other (specify below) 3 line pipeline
 2 Sewer lines 7 Pit privy 12 Fertilizer storage
 3 Watertight sewer lines 8 Sewage lagoon 13 Insecticide storage
 4 Lateral lines 9 Feedyard 14 Abandoned water well
 5 Cess pool 10 Livestock pens 15 Oil well/Gas well

Direction from well? N How many feet? 200

FROM	TO	PLUGGING MATERIALS
<u>0</u>	<u>6</u>	<u>Bentonite (8")</u>
<u>6</u>	<u>12.8</u>	<u>Bentonite (2")</u>

MW6

RECEIVED
 OCT 22 2004
 BUREAU OF WATER

GeoCore #213

7 CONTRACTOR'S OF LANDOWNER'S CERTIFICATION: This water well was plugged under my jurisdiction and was completed on (mo/day/year) 10/18/2004 and this record is true to the best of my knowledge and belief. Kansas Water Well Contractor's License No. 527 This Water Well Record was completed on (mo/day/year) 10/19/2004 under the business name of GeoCore Inc. by (signature) Dale Koll