


1	LOCATION OF WATER WELL:	Fraction	Section Number	Township Number	Range Number
	County: Pratt	NW 1/4 NW 1/4 Se 1/4	1	27S	11 E/W

Distance and direction from nearest town or city street address of well if located within city?
 Two miles west of Cunningham and 5 north off 54 Hwy

2 WATER WELL OWNER: Bonnie M Guthrie Living Trust
 RR #, St. Address, Box #: 16832 NW 40th Board of Agriculture, Division of Water Resources
 City, State, ZIP Code: Cunningham, KS 67035 Application Number:

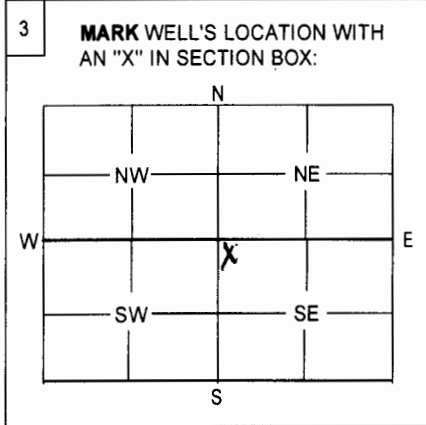

4 DEPTH OF WELL 141 ft.
 WELL'S STATIC WATER LEVEL 25 ft.
 WELL WAS USED AS:
 1 Domestic 5 Public Water Supply 9 Dewatering
 2 Irrigation 6 Oil Field Water Supply 10 Monitoring Well
 3 Feedlot 7 Domestic (Lawn & Garden) 11 Injection Well
 4 Industrial 8 Air Conditioning 12 Other
 Was a chemical / bacteriological sample submitted to Department? Yes No X
 if yes, mo/day/yr sample was submitted
 Water Well Disinfected: Yes No X

5 TYPE OF BLANK CASING USED:
 1 Steel 3 RMP (SR) 5 Wrought 7 Fiberglass 9 Other (Specify below)
 2 PVC 4 ABS 6 Asbestos-Cement 8 Concrete Tile
 Blank casing diameter 5 in. Was casing pulled? Yes X No
 Casing height above or below land surface 5 ft B.L.S. in. If yes, how much 5'

6 GROUT PLUG MATERIAL: 1 Neat cement 2 Cement grout 3 Bentonite 4 Other Topsoil
 Grout Plug Intervals: From 141 ft. to 5 ft B.L.S. ft., From 5 ft B.L.S. ft. to 0 ft., From to ft.
 What is the nearest source of possible contamination:
 1 Septic tank 6 Seepage pit 11 Fuel storage 16 Other (specify below) pasture
 2 Sewer lines 7 Pit privy 12 Fertilizer storage
 3 Watertight sewer lines 8 Sewage lagoon 13 Insecticide storage
 4 Lateral lines 9 Feedyard 14 Abandoned water well
 5 Cess pool 10 Livestock pens 15 Oil well/Gas well
 Direction from well? 999 How many feet? 999

FROM	TO	PLUGGING MATERIALS
141'	5'	Bentonite chips, hydrated
5'	0'	Topsoil
		Revised Copy

CORRECTED

7 CONTRACTOR'S OF LANDOWNER'S CERTIFICATION: This water well was plugged under my jurisdiction and was completed on (mo/day/year) 8/10/09 and this record is true to the best of my knowledge and belief. Kansas Water Well Contractor's License No. 665 This Water Well Record was completed on (mo/day/year) 8/11/09 under the business name of Pratt Well Service, Inc.
 by (signature) *[Signature]*

INSTRUCTIONS: Use typewriter or ball point pen. Please press firmly and print clearly. Please fill in blanks, underline or circle the correct answers. Send top three copies to Kansas Department of Health and Environment, Bureau of Water, Geology Section, 1 000 SW Jackson St., Ste. 420, Topeka, Kansas 66612-1367. Telephone: 785/296-5522. Send one to Water Well Owner and retain one for your records.