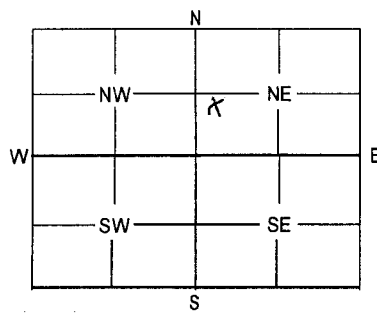


1	LOCATION OF WATER WELL:	Fraction	Section Number	Township Number	Range Number
	County: Pratt	NW 1/4 SW 1/4 NE 1/4	10	27S	11

Distance and direction from nearest town or city street address of well if located within city?  
 NE 45th Street and NE 130th Ave.

2	WATER WELL OWNER: <u>Velma Henrichs</u> RR #, St. Address, Box # <u>408 Southwind Drive</u> City, State, ZIP Code <u>Valley Center, KS 67147-2666</u>	Board of Agriculture, Division of Water Resources Application Number:
---	---	--

3	MARK WELL'S LOCATION WITH AN "X" IN SECTION BOX: 	4	DEPTH OF WELL <u>130</u> ft. WELL'S STATIC WATER LEVEL <u>58</u> ft. WELL WAS USED AS: 1 Domestic 2 Irrigation 3 Feedlot 4 Industrial 5 Public Water Supply 6 Oil Field Water Supply 7 Domestic (Lawn & Garden) 8 Air Conditioning 9 Dewatering 10 Monitoring Well 11 Injection Well 12 Other
---	---	---	---

Was a chemical / bacteriological sample submitted to Department? Yes \_\_\_\_\_ No X  
 if yes, mo/day/yr sample was submitted \_\_\_\_\_  
 Water Well Disinfected: Yes \_\_\_\_\_ No X

5	TYPE OF BLANK CASING USED: 1 Steel 2 PVC 3 RMP (SR) 4 ABS 5 Wrought 6 Asbestos-Cement 7 Fiberglass 8 Concrete Tile 9 Other (Specify below)	Blank casing diameter <u>5</u> in. Casing height above or below land surface <u>3 ft B.L.S.</u> in.	Was casing pulled? Yes <u>X</u> No _____ If yes, how much <u>5'</u>
---	---	--	--

6	GROUT PLUG MATERIAL: 1 Neat cement 2 Cement grout 3 Bentonite 4 Other Topsoil Grout Plug Intervals: From <u>130</u> ft. to <u>3 ft B.L.S.</u> ft., From <u>3 ft B.L.S.</u> ft. to <u>0</u> ft., From _____ to _____ ft	What is the nearest source of possible contamination: 1 Septic tank 2 Sewer lines 3 Watertight sewer lines 4 Lateral lines 5 Cess pool 6 Seepage pit 7 Pit privy 8 Sewage lagoon 9 Feedyard 10 Livestock pens 11 Fuel storage 12 Fertilizer storage 13 Insecticide storage 14 Abandoned water well 15 Oil well/Gas well 16 Other (specify below) <u>pasture</u>
---	---	---

Direction from well? \_\_\_\_\_ How many feet? \_\_\_\_\_

FROM	TO	PLUGGING MATERIALS
130'	3'	Bentonite chips, hydrated
3'	0'	Topsoil

7	CONTRACTOR'S OF LANDOWNER'S CERTIFICATION: This water well was plugged under my jurisdiction and was completed on (mo/day/year) <u>8/27/09</u> and this record is true to the best of my knowledge and belief. Kansas Water Well Contractor's License No. <u>665</u> This Water Well Record was completed on (mo/day/year) <u>8/28/09</u> under the business name of <u>Pratt Well Service, Inc.</u> by (signature) <u>[Signature]</u>
---	---

INSTRUCTIONS: Use typewriter or ball point pen. Please press firmly and print clearly. Please fill in blanks, underline or circle the correct answers. Send top three copies to Kansas Department of Health and Environment, Bureau of Water, Geology Section, 1 000 SW Jackson St., Ste. 420, Topeka, Kansas 66612-1367. Telephone: 785/296-5522. Send one to Water Well Owner and retain one for your records.