

**WATER WELL PLUGGING RECORD Form WWC-5P** KSA 82a-1212 ID NO.  

1 LOCATION OF WATER WELL: Fraction NE 1/4 NE 1/4 SE 1/4 SE 1/4 Section Number 30 Township Number T07 S Range Number 11  E  W


County: Pratt  
 Street/Rural Address of Well Location; if unknown, distance & direction from nearest town or intersection: If at owner's address, check here

Global Positioning Systems (GPS) information:  
 Latitude: 37 39' 48.0" (in decimal degrees)  
 Longitude: 98 33' 26.4" (in decimal degrees)  
 Elevation: 1720  
 Datum:  WGS84,  NAD83,  NAD27

2 WATER WELL OWNER: U.S. Geological Survey  
 RR#, St. Address, Box #: 4521 Quail Crest place  
 City, State ZIP Code: Lawrence, KS. 66049

Collection Method:  
 GPS unit (Make/Model: Garmin)  
 Digital Map/Photo,  Topographic Map,  Land Survey  
 Est. Accuracy:  < 3 m,  3-5 m,  5-15 m,  > 15 m

3 MARK WELL'S LOCATION WITH AN "X" IN SECTION BOX:

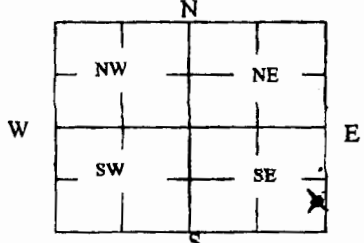

4 DEPTH OF WELL 129 ft.

WELL'S STATIC WATER LEVEL 15.4 ft

- WELL WAS USED AS:
- Domestic
  - Public Water Supply
  - Dewatering
  - Irrigation
  - Oil Field Water Supply
  - Monitoring
  - Feedlot
  - Domestic (Lawn & Garden)
  - Injection Well
  - Industrial
  - Air Conditioning
  - Other \_\_\_\_\_

Was a chemical/bacteriological sample submitted to Department? Yes  No

5 TYPE OF BLANK CASING USED:

- Steel
- RMP (SR)
- Wrought
- Fiberglass
- Other (Specify below) \_\_\_\_\_
- PVC
- ABS
- Asbestos-Cement
- Concrete Tile

Blank casing diameter 2 in. Was casing pulled? Yes  No  If yes, how much \_\_\_\_\_  
 Casing height above or below land surface 36 in.

6 GROUT PLUG MATERIAL:  Neat cement  Cement grout  Bentonite  Other \_\_\_\_\_

Grout Plug Intervals: From 129 ft. to 3 ft., From \_\_\_\_\_ ft. to \_\_\_\_\_ ft., From \_\_\_\_\_ to \_\_\_\_\_ ft.

- What is the nearest source of possible contamination:
- Septic tank
  - Seepage pit
  - Fuel Storage
  - Other (specify below) \_\_\_\_\_
  - Sewer lines
  - Pit privy
  - Fertilizer storage
  - Watertight sewer lines
  - Sewage lagoon
  - Insecticide storage
  - Lateral lines
  - Feedyard
  - Abandoned water well
  - Oil well/Gas well
  - Cess pool
  - Livestock pens
- Direction from well? \_\_\_\_\_  
 How many feet? \_\_\_\_\_

FROM	TO	PLUGGING MATERIALS	FROM	TO	PLUGGING MATERIALS
<u>129</u>	<u>3</u>	<u>Bentonite grout</u>			

7 CONTRACTOR'S OR LANDOWNER'S CERTIFICATION: This water well was plugged under my jurisdiction and was completed on (mo/day/year) 5/13/10 and this record is true to the best of my knowledge and belief. Kansas Water Well Contractor's License No. 823. This Water Well Record was completed on (mo/day/year) 5/13/10 under the business name of U.S. Geological Survey by (signature) [Signature]

INSTRUCTIONS: Use typewriter or ballpoint pen. Please press firmly and print clearly. Please fill in blanks, underline or circle the correct answers. Send top three copies to Kansas Department of Health and Environment, Bureau of Water, Geology Section, 1000 SW Jackson St., Ste. 420, Topeka, Kansas 66612-1367. Telephone: 785/296-5524. Send one to Water Well Owner and retain one for your records. Visit us at <http://www.kdheks.gov/waterwell/index.html>.

Check one:  White Copy  Blue Copy  Pink Copy