


WATER WELL PLUGGING RECORD Form WWC-5P KSA 82a-1212 ID NO. [ ]

1 LOCATION OF WATER WELL: County: Pratt Fraction: SE 1/4 SE 1/4 SE 1/4 NE 1/4 Section Number: 31 Township Number: T 27 S Range Number: 11  E  W

Street/Rural Address of Well Location; if unknown, distance & direction from nearest town or intersection: If at owner's address, check here  Global Positioning Systems (GPS) information: Latitude: 37 39' 09.1" (in decimal degrees) Longitude: 98 33' 27.3" (in decimal degrees) Elevation: 1226 Datum:  WGS84,  NAD83,  NAD27 Collection Method:  GPS unit (Make/Model: GORMAN)  Digital Map/Photo,  Topographic Map,  Land Survey Est. Accuracy:  < 3 m,  3-5 m,  5-15 m,  > 15 m

2 WATER WELL OWNER: U.S. Geological Survey RR#, St. Address, Box #: 4621 Quail Crest Place City, State ZIP Code: Lawrence, KS 66049

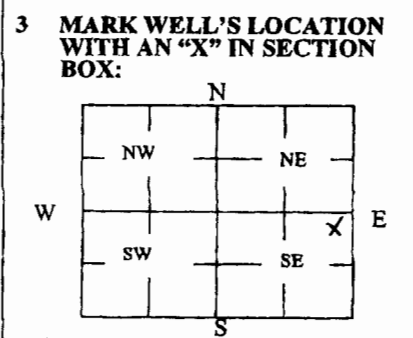

4 DEPTH OF WELL 125 ft. WELL'S STATIC WATER LEVEL 2.8 ft. WELL WAS USED AS:  Domestic  Public Water Supply  Dewatering  Irrigation  Oil Field Water Supply  Monitoring  Feedlot  Domestic (Lawn & Garden)  Injection Well  Industrial  Air Conditioning  Other \_\_\_\_\_ Was a chemical/bacteriological sample submitted to Department? Yes  No

5 TYPE OF BLANK CASING USED:  Steel  RMP (SR)  Wrought  Fiberglass  Other (Specify below)  PVC  ABS  Asbestos-Cement  Concrete Tile Blank casing diameter 2 in. Was casing pulled? Yes  No  If yes, how much \_\_\_\_\_ Casing height above or below land surface 36 in.

6 GROUT PLUG MATERIAL:  Neat cement  Cement grout  Bentonite  Other \_\_\_\_\_ Grout Plug Intervals: From 125 ft. to 3 ft., From \_\_\_\_\_ ft. to \_\_\_\_\_ ft., From \_\_\_\_\_ to \_\_\_\_\_ ft. What is the nearest source of possible contamination:  Septic tank  Sewer lines  Watertight sewer lines  Lateral lines  Cess pool  Seepage pit  Pit privy  Sewage lagoon  Feedyard  Livestock pens  Fuel Storage  Fertilizer storage  Insecticide storage  Abandoned water well  Oil well/Gas well  Other (specify below) \_\_\_\_\_ Direction from well? East How many feet? 600'

FROM	TO	PLUGGING MATERIALS	FROM	TO	PLUGGING MATERIALS
125'	3'	Bentonite Grout			

7 CONTRACTOR'S OR LANDOWNER'S CERTIFICATION: This water well was plugged under my jurisdiction and was completed on (mo/day/year) 5/14/10 and this record is true to the best of my knowledge and belief. Kansas Water Well Contractor's License No. 823. This Water Well Record was completed on (mo/day/year) 5/14/10 under the business name of U.S. Geological Survey by (signature) [Signature]

INSTRUCTIONS: Use typewriter or ballpoint pen. Please press firmly and print clearly. Please fill in blanks, underline or circle the correct answers. Send top three copies to Kansas Department of Health and Environment, Bureau of Water, Geology Section, 1000 SW Jackson St., Ste. 420, Topeka, Kansas 66612-1367. Telephone: 785/296-5524. Send one to Water Well Owner and retain one for your records. Visit us at <http://www.kdheks.gov/waterwell/index.html>.

Check one:  White Copy  Blue Copy  Pink Copy