

WATER WELL RECORD


Form WWC-5

Division of Water Resources App. No.

1 LOCATION OF WATER WELL: County: Pratt Fraction: NW 1/4 NW 1/4 SE 1/4 Section Number: 22 Township No. T 27 S Range Number R 11 E NW

Street/Rural Address of Well Location: 2 E. 2 N. Cario Global Positioning System (GPS) information: Latitude: Longitude: Elevation: Datum: Collection Method: Est. Accuracy:

2 WATER WELL OWNER: Luella Ditto RR#, Street Address, Box #: 809 W. 5th St City, State, ZIP Code: Pratt, KS 67124

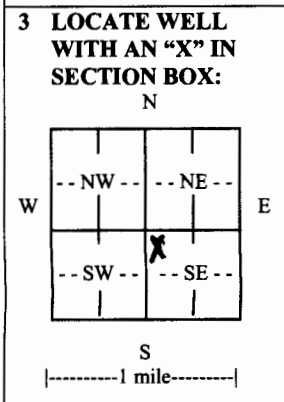

4 DEPTH OF COMPLETED WELL: 10 2/8 ft. Depth(s) Groundwater Encountered (1) 4 7/8 ft. (2) ft. (3) ft. WELL'S STATIC WATER LEVEL: 48 ft. below land surface measured on 2-25-12 Pump test data: Well water was ft. after hours pumping gpm EST. YIELD: 30 gpm Well water was ft. after hours pumping gpm Bore Hole Diameter in. to ft., and in. to ft. WELL WATER TO BE USED AS: [X] Domestic [ ] Feedlot [ ] Oil field water supply [ ] Dewatering [ ] Other (Specify below) [ ] Irrigation [ ] Industrial [ ] Domestic-lawn & garden [ ] Monitoring well Was a chemical/bacteriological sample submitted to Department? [ ] Yes [X] No If yes, mo/day/yr sample was submitted Water well disinfected? [X] Yes [ ] No

5 TYPE OF CASING USED: [ ] Steel [X] PVC [ ] Other CASING JOINTS: [X] Glued [ ] Clamped [ ] Welded [ ] Threaded Casing diameter 5 in. to 10 1/2 ft., Diameter 1/2 in. to ft., Diameter in. to ft. Casing height above land surface 24 in., Weight 160 lbs./ft., Wall thickness or gauge No. TYPE OF SCREEN OR PERFORATION MATERIAL: [ ] Steel [ ] Stainless Steel [X] PVC [ ] Other (Specify) [ ] Brass [ ] Galvanized Steel [ ] None used (open hole) SCREEN OR PERFORATION OPENINGS ARE: [ ] Continuous slot [ ] Mill slot [ ] Gauze wrapped [ ] Torch cut [ ] Drilled holes [ ] None (open hole) [ ] Louvered shutter [ ] Key punched [ ] Wire wrapped [X] Saw cut [ ] Other (specify) SCREEN-PERFORATED INTERVALS: From 90 ft. to 102 ft., From ft. to ft. From ft. to ft. From ft. to ft. GRAVEL PACK INTERVALS: From 20 ft. to 60 ft., From 6.5 ft. to 10.2 ft. From ft. to ft. From ft. to ft.

6 GROUT MATERIAL: [ ] Neat cement [ ] Cement grout [X] Bentonite [ ] Other Grout Intervals: From 0 ft. to 20 ft., From 60 ft. to 6.5 ft., From ft. to ft. What is the nearest source of possible contamination: [ ] Septic tank [ ] Lateral lines [ ] Pit privy [ ] Livestock pens [ ] Insecticide storage [ ] Other (specify below) [ ] Sewer lines [ ] Cesspool [ ] Sewage lagoon [ ] Fuel storage [X] Abandoned water well [ ] Watertight sewer lines [ ] Seepage pit [ ] Feedyard [ ] Fertilizer storage [ ] Oil well/gas well Direction from well NE Distance from well 1500'

Table with 6 columns: FROM, TO, LITHOLOGIC LOG, FROM, TO, LITHO. LOG (cont.) or PLUGGING INTERVALS. Rows describe geological layers: 0-2 Soil, 2-6 Yellow Sand, 6-38 Sand, 38-39 Hard White Clay, 39-47 Fine Sand, 47-52 Coarse Sand w/Clay streaks, 52-56 Sand, 56-70 Brown Clay, 70-90 Fine Sand, 90-102 Sand.

7 CONTRACTOR'S OR LANDOWNER'S CERTIFICATION: This water well was [X] constructed, [ ] reconstructed, or [ ] plugged under my jurisdiction and was completed on (mo/day/year) 2-25-12 and this record is true to the best of my knowledge and belief. Kansas Water Well Contractor's License No. 149 This Water Well Record was completed on (mo/day/year) 3-11-12 under the business name of Lyman's Inc by (signature) Nelson Lyman

INSTRUCTIONS: Use typewriter or ball point pen. PLEASE PRESS FIRMLY and PRINT clearly. Please fill in blanks and check the correct answers. Send three copies (white, blue, pink) to Kansas Department of Health and Environment, Bureau of Water, Geology Section, 1000 SW Jackson St., Suite 420, Topeka, Kansas 66612-1367. Telephone 785-296-5522. Send one copy to WATER WELL OWNER and retain one for your records. Include fee of \$5.00 for each constructed well. Visit us at http://www.kdheks.gov/waterwell/index.html.