

revised

WATER WELL RECORD


Form WWC-5

Division of Water Resources App. No. [ ]

1 LOCATION OF WATER WELL: County: Pratt Fraction 1/4 1/4 NW 1/4 NW 1/4 Section Number 1 Township No. T 27 S Range Number R 11 [ ]E [X]W

Street/Rural Address of Well Location: NE 60th ST & NE 140th Ave, 800 ft East, South into Global Positioning System (GPS) information: Latitude: 37.725236 Longitude: -98.483032

2 WATER WELL OWNER: Northern Natural Gas(WIW#1) RR#, Street Address, Box #: P.O. Box 3330 City, State, ZIP Code : Omaha, NE 68103-0300

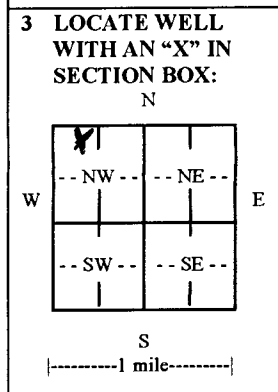

3 LOCATE WELL WITH AN 'X' IN SECTION BOX: 4 DEPTH OF COMPLETED WELL 137 ft. Depth(s) Groundwater Encountered (1) 30 ft. (2) ft. (3) ft. WELL'S STATIC WATER LEVEL 30 ft. below land surface measured on mo/day/yr. 09/24/12

5 TYPE OF CASING USED: [ ] Steel [X] PVC [ ] Other CASING JOINTS: [X] Glued [ ] Clamped [ ] Welded [ ] Threaded Casing diameter .5 in. to ft., Diameter in. to ft., Diameter in. to ft. Casing height above land surface .36 in., Weight lbs./ft., Wall thickness or gauge No.

6 GROUT MATERIAL: [ ] Neat cement [ ] Cement grout [X] Bentonite [ ] Other Grout Intervals: From 55 ft. to 0 ft., From ft. to ft., From ft. to ft. What is the nearest source of possible contamination: [ ] Septic tank [ ] Lateral lines [ ] Pit privy [ ] Livestock pens [ ] Insecticide storage [ ] Other (specify below)

Table with 6 columns: FROM, TO, LITHOLOGIC LOG, FROM, TO, LITHO. LOG (cont.) or PLUGGING INTERVALS. Rows show depth intervals from 0 to 137 feet with lithology descriptions like Sand, Sand & Light Yellow Clay, Sand & Gray/Yellow Clay, Sand & Little Gravel, Sand & Gravel, Sand, Gravel & Red Clay, Red Clay, Red Clay.

7 CONTRACTOR'S OR LANDOWNER'S CERTIFICATION: This water well was [X] constructed, [ ] reconstructed, or [ ] plugged under my jurisdiction and was completed on (mo/day/year) 09/24/12 and this record is true to the best of my knowledge and belief. Kansas Water Well Contractor's License No. 665 This Water Well Record was completed on (mo/day/year) 09/25/12 under the business name of Pratt Well Service, Inc. by (signature) [ ]

INSTRUCTIONS: Use typewriter or ball point pen. PLEASE PRESS FIRMLY and PRINT clearly. Please fill in blanks and check the correct answers. Send three copies (white, blue, pink) to Kansas Department of Health and Environment, Bureau of Water, Geology Section, 1000 SW Jackson St., Suite 420, Topeka, Kansas 66612-1367. Telephone 785-296-5524. Send one copy to WATER WELL OWNER and retain one for your records. Include fee of \$5.00 for each constructed well. Visit us at http://www.kdheks.gov/waterwell/index.html.