

USE TYPEWRITER OR BALL POINT PEN-PRESS FIRMLY, PRINT CLEARLY.


T R EW sec 1/4 1/4 1/4 No.

WATER WELL RECORD
KSA 82a-1201-1215

Kansas State Dept. Of Health
(Water Well Contractors)
Forbes-Bldg. 740
Topeka, Kansas 66620

1 Location of well: County Pratt Township name Haynesville Fraction CNE 1/4 Section number 7 Town number T275 Range number R11W

Distance and direction from nearest town or city: _____ 3 Owner of well: Wayne W. Williams
Street address of well location if in city: _____ Address: Box 18
Pratt, Kas 67569

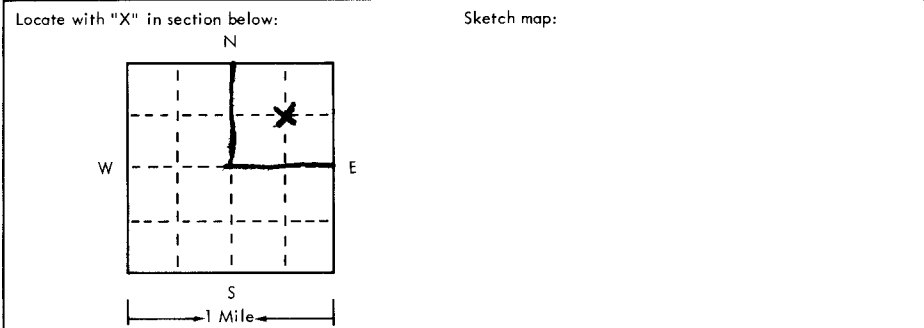

4 Well depth: 140 ft. Date of completion 3/18/75
Well diameter 28 in. Bore Hole

5 Cable tool Rotary Driven Dug
 Hollow rod Jetted Bored Reverse rotary

6 Use: Domestic Public supply Industry
 Irrigation Air conditioning Commercial
 Test well

7 Casing: Material Steel Height: above below
Threaded Welded Surface 12 in.
Diam. _____ Weight 7.2 lb./ft.
16 in. to 140 ft. depth Drive shoe? Yes No
_____ in. to _____ ft. depth

2	Type and color of material	From	To
	<u>Top Soil</u>	<u>0'</u>	<u>11'</u>
	<u>Fine (dry) Sand</u>	<u>11'</u>	<u>19'</u>
	<u>Sand & Clay Strips</u>	<u>19'</u>	<u>33'</u>
	<u>Brown Clay</u>	<u>33'</u>	<u>46'</u>
	<u>Course Sand (dark)</u>	<u>46'</u>	<u>51'</u>
	<u>Medium Fine Sand Clean</u>	<u>51'</u>	<u>63'</u>
	<u>White Clay</u>	<u>63'</u>	<u>65'</u>
	<u>Med. Fine Gravel (very clean)</u>	<u>86'</u>	<u>140'</u>
	<u>Very Hard Clays</u>	<u>140'</u>	
	<u>Casing has 1/4" Steel plate</u>		
	<u>Welded to bottom</u>		
	<u>No Red Bed</u>		
	<u>"Analysis"</u>		
	<u>Wayne W. Williams</u>		
	<u>Salt 95 Per Million</u>		
	<u>Hardness (use a second sheet)</u>		

8 Screen: W.A. Brown Enterprises
Manufacturer St. Joe, Mo Dia. 16
Type 94 Length 60
Slot/gauge 94 Length 60
Set between 80 ft. and 14 ft.

Fittings:
Gravel pack Yes No Size range of material 1/8" - 3/8"

9 Static water level:
52 ft. below land surface Date 3/18/75

10 Pumping level below land surfaces:
87 ft. after 2 hrs. pumping 1100 g.p.m.
87 ft. after 8 hrs. pumping 1100 g.p.m.
Estimated maximum yield 2000 g.p.m.

11 Water sample submitted:
 Yes No Date Jan 1975

12 Well head completion: 12"
 Pitless adapter Inches above grade

13 Well grouted? Yes No
 Neat cement Bentonite _____
Depth: From 0 ft. to 17 ft.

14 Nearest source of possible contamination:
ft. None Direction _____ Type in field
Well disinfected upon completion? Yes No

15 Pump: Not installed
Manufacturer's name Jait-AC Mfg
Model number _____ HP _____ Volt _____
Length of drop pipe 120 ft. capacity 750 g.m.p.
Type:
 Submersible Turbine
 Jet Reciprocating
 Centrifugal Other

16 Remarks: elevation Good - Excellent
(Dupree - Peterson
Lab. Hutchinson Kas

Topography:
 Hill
 Slope
 Upland
 Valley

17 Water well contractor's certification:
This well was drilled under my jurisdiction and this report is true to the best of my knowledge and belief.
Wells Drilling Co 112
Business name _____ License No. _____
Address 1030 N. 5th St
Signed Del Wells Date 4/18/75
Authorized representative Kingman Kas

Forward the white, blue and pink copies to the Kansas State Dept. Of Health.

Form WWC-5