USE TYPEWRITER OR BALL POINT PEN-PRESS FIRMLY, PRINT CLEARLY.

WATER WELL RECORD
KSA 82a-1201-1215

Kansas Department of Health and Environment-Division of Environment
(Water well Contractors)
Topeka, Kansas 66620

1. Location of well:	County	Fraction	Section number	Township number	Range number
	Pratt	se 1/4 ne1/4 ne1/4	24	T 27 S	R 11 E/W

2. Distance and direction from nearest town or city:
2-W 2½-N West side from Cunningham, Ks.
Street address of well location if in city:

3. Owner of well: Northern Natural Gas co.
R.R. or street: Box 88
City, state, zip code: Lyons, Kansas 67554

4. Locate with "X" in section below: Sketch map:

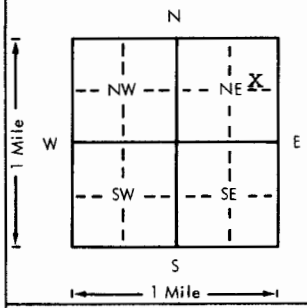

6. Bore hole dia. 9 7/8 in. Completion date ____
Well depth 140 ft. 1-19-79

7. __ Cable tool X Rotary __ Driven __ Dug
__ Hollow rod __ Jetted __ Bored __ Reverse rotary

8. Use: X Domestic __ Public supply __ Industry
__ Irrigation __ Air conditioning __ Stock
__ Lawn __ Oil field water __ Other

9. Casing: Material pvc Height: Above or below
Threaded ____ Welded x Surface 18 in.
RMP ____ PVC ____ Weight ____ lbs./ft.
Dia. 5½ in. to 140 ft. depth Wall Thickness: inches or
Dia. ____ in. to ____ ft. depth gage No. .258

5. Type and color of material	From	To
top soil	0	2
brown clay	2	11
sand & gravel	11	42
clay	42	51
sand & gravel	51	68
clay	68	83
sand & gravel	83	118
brown clay	118	127
sand & gravel	127	143

(Use a second sheet if needed)

10. Screen: Manufacturer's name CertainTeed
Type pvc Dia. ____
Slot/~~gage~~ 1/16 Length 30
Set between 140 ft. and 110 ft.
____ ft. and ____ ft.
Gravel pack? X Size range of material ½3/4 3/8

11. Static water level: mo./day/yr.
38 ft. below land surface Date 1-19-79

12. Pumping level below land surfaces: na
____ ft. after ____ hrs. pumping ____ g.p.m.
____ ft. after ____ hrs. pumping ____ g.p.m.
Estimated maximum yield ____ g.p.m.

13. Water sample submitted: mo./day/yr.
X Yes ____ No Date 1-19-79

14. Well head completion:
____ Pitless adapter ____ Inches above grade

15. Well grouted? X
With: x Neat cement ____ Bentonite ____ Concrete
Depth: From 0 ft. to 10 ft.

16. Nearest source of possible contamination:
ft. 20 Direction east Type waterwell
Well disinfected upon completion? hth Yes ____ No

17. Pump: ____ Not installed
Manufacturer's name Red Jacket
Model number 10EC HP 5 Volts ~~115~~ 230
Length of drop pipe 105' ft. capacity 50 g.p.m.
Type:
X Submersible ____ Turbine
____ Jet ____ Reciprocating
____ Centrifugal ____ Other

18. Elevation:

Topography:
____ Hill
____ Slope
____ Upland
X Valley

19. Remarks:

20. Water well contractor's certification:
This well was drilled under my jurisdiction and this report is true to the best of my knowledge and belief.
Rosencrantz-Bemis 134
Business name License No.
Address Great Bend, Kansas 67530
Signed Sandy Kilgore Date 2-8-79
Authorized representative

T 27 R 11 (W) E Sec 24 1/4 se 1/4 ne 1/4 ne 1/4

Forward the white, blue and pink copies to the Department of Health and Environment

Form WWC-5

MI-1023