WATER WELL RECORD Form WWC-5 KSA 82a-1212

1 LOCATION OF WATER WELL: County: PRATT | Fraction: SW ¼ SW ¼ SW ¼ | Section Number: 26 | Township Number: T 27 S | Range Number: R 11 E(W)

Distance and direction from nearest town or city street address of well if located within city?
3 miles east and 1 north (from Cairo)

2 WATER WELL OWNER: Kansas Geological Survey
RR#, St. Address, Box # : 1930 Constant Ave
City, State, ZIP Code : Lawrence, Kansas 66044

Board of Agriculture, Division of Water Resources
Application Number:

3 LOCATE WELL'S LOCATION WITH AN "X" IN SECTION BOX:

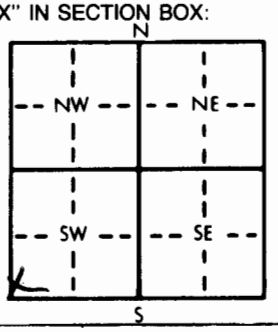

4 DEPTH OF COMPLETED WELL 23 ft. ELEVATION: 1661
Depth(s) Groundwater Encountered 1. 3 ft. 2. ft. 3. ft.
WELL'S STATIC WATER LEVEL 10 ft. below land surface measured on mo/day/yr 6/22/63
Pump test data: Well water was ft. after hours pumping gpm
Est. Yield gpm: Well water was ft. after hours pumping gpm
Bore Hole Diameter 6 3/4 in. to ft., and in. to ft.
WELL WATER TO BE USED AS: 5 Public water supply 8 Air conditioning 11 Injection well
1 Domestic 3 Feedlot 6 Oil field water supply 9 Dewatering 12 Other (Specify below)
2 Irrigation 4 Industrial 7 Lawn and garden only 10 Observation well
Was a chemical/bacteriological sample submitted to Department? Yes No X; If yes, mo/day/yr sample was submitted
Water Well Disinfected? Yes No X

5 TYPE OF BLANK CASING USED: 5 Wrought iron 8 Concrete tile CASING JOINTS: Glued X Clamped
1 Steel 3 RMP (SR) 6 Asbestos-Cement 9 Other (specify below) Welded
2 PVC 4 ABS 7 Fiberglass Threaded
Blank casing diameter 2 in. to 23 ft., Dia in. to ft., Dia in. to ft.
Casing height above land surface 18 in., weight lbs./ft. Wall thickness or gauge No. Schedule 40

TYPE OF SCREEN OR PERFORATION MATERIAL: 7 PVC 10 Asbestos-cement
1 Steel 3 Stainless steel 5 Fiberglass 8 RMP (SR) 11 Other (specify)
2 Brass 4 Galvanized steel 6 Concrete tile 9 ABS 12 None used (open hole)

SCREEN OR PERFORATION OPENINGS ARE: 5 Gauzed wrapped 8 Saw cut 11 None (open hole)
1 Continuous slot 3 Mill slot 6 Wire wrapped 9 Drilled holes
2 Louvered shutter 4 Key punched 7 Torch cut 10 Other (specify)

SCREEN-PERFORATED INTERVALS: From 21 ft. to 23 ft., From ft. to ft.
From ft. to ft., From ft. to ft.
GRAVEL PACK INTERVALS: From 5 ft. to 21 ft., From ft. to ft.
From ft. to ft., From ft. to ft.

6 GROUT MATERIAL: 1 Neat cement 2 Cement grout 3 Bentonite 4 Other bankfill
Grout Intervals: From 0 ft. to 5 ft., From ft. to ft., From 5 ft. to 23 ft.

What is the nearest source of possible contamination:
1 Septic tank 4 Lateral lines 7 Pit privy 10 Livestock pens 14 Abandoned water well
2 Sewer lines 5 Cess pool 8 Sewage lagoon 11 Fuel storage 15 Oil well/Gas well
3 Watertight sewer lines 6 Seepage pit 9 Feedyard 12 Fertilizer storage 16 Other (specify below)
13 Insecticide storage stream
Direction from well? How many feet? 200 feet north

FROM	TO	LITHOLOGIC LOG	FROM	TO	LITHOLOGIC LOG
0	3	02 Sand and silt			
3	23	17 Sand and gravel			

7 CONTRACTOR'S OR LANDOWNER'S CERTIFICATION: This water well was (1) constructed, (2) reconstructed, or (3) plugged under my jurisdiction and was completed on (mo/day/year) 7/14/63 and this record is true to the best of my knowledge and belief. Kansas Water Well Contractor's License No. This Water Well Record was completed on (mo/day/yr) 11/1/63
under the business name of KGS by (signature) R. Allen Monfordton

INSTRUCTIONS: Use typewriter or ball point pen, *PLEASE PRESS FIRMLY* and *PRINT* clearly. Please fill in blanks, underline or circle the correct answers. Send top three copies to Kansas Department of Health and Environment, Division of Environment, Environmental Geology Section, Topeka, KS 66620. Send one to WATER WELL OWNER and retain one for your records.

OFFICE USE ONLY
T 27 R 11 E(W) SEC. 26 SW¼ SW¼ SW¼