

County: Pratt Fraction: SE, SE, NW Sec. 31 T. 27 S R. 11 W

CORRECTION(S) to WATER WELL COMPLETION RECORD Form WWC-5 (to rectify lacking or incorrect information)

Owner: Palomino Petroleum WWC5P 51' OFWS

If location corrected, was listed as: _____ Location changed to: _____
Section-Township-Range: _____
Fraction (1/4 calls): _____

Other changes: Initial statements: Lease name & DWR permit number not provided.

Changed to: Rachel Davidson 31-1. Temp Permit #20160157

Comments: Original well owner was C&M Exploration, P.O. Box 14331, Tulsa, OK.

Verification method: Water Well Contractor confirmed information.


Initials: PKC Date: 2/15/2022

Submitted by: Kansas Geological Survey, Data Resources Library, 1930 Constant Ave., Lawrence, KS 66047-3724
 Kansas Dept. of Health & Environment, Bureau of Water, 1000 SW Jackson, Suite 420, Topeka, KS 66612-1367

1	LOCATION OF WATER WELL:	Fraction	Section Number	Township Number	Range Number
County:	<u>Pruitt</u>	<u>SE 1/4 SE 1/4 NW 1/4</u>	<u>31</u>	<u>27</u>	<u>11</u> E/W

Distance and direction from nearest town or city street address of well if located within city? Hwy 84 + SE 100th Ave Go North 1/8 mile + Turn west on Bypass Road for 1 mile then North on NE 90th Ave for 1/2 mile + east into for 1/2 mile

2 WATER WELL OWNER: Palomino Petroleum
 RR #, St. Address, Box # 4924 SE 84th St
 City, State, ZIP Code : Newton KS 67114
 Board of Agriculture, Division of Water Resources
 Application Number: _____

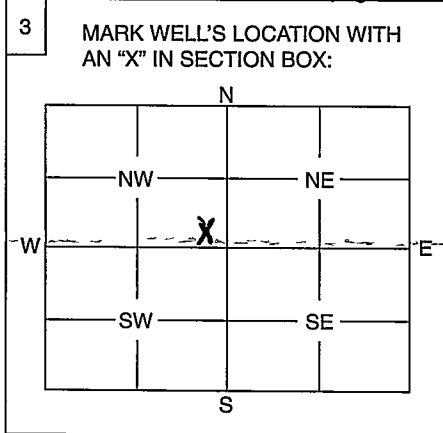

4 DEPTH OF WELL 51 ft.
 WELL'S STATIC WATER LEVEL 6 ft.
 WELL WAS USED AS:
 1 Domestic 5 Public Water Supply 9 Dewatering
 2 Irrigation 6 Oil Field Water Supply 10 Monitoring Well
 3 Feedlot 7 Domestic (Lawn & Garden) 11 Injection Well
 4 Industrial 8 Air Conditioning 12 Other

Was a chemical / bacteriological sample submitted to Department? Yes No X
 If yes, mo/day/yr sample was submitted

Water Well Disinfected: Yes X No

5 TYPE OF BLANK CASING USED:
 1 Steel 3 RMP (SR) 5 Wrought 7 Fiberglass 9 Other (Specify below)
2 PVC 4 ABS 6 Asbestos-Cement 8 Concrete Tile

Blank casing diameter 5 in. Was casing pulled? Yes No X If yes, how much

Casing height above or below land surface 4.9 Below in.

6 GROUT PLUG MATERIAL: 1 Neat cement 2 Cement grout 3 Bentonite 4 Other

Grout Plug Intervals: From 51 ft. to 4 ft., From ft. to ft., From to

What is the nearest source of possible contamination:
 1 Septic tank 6 Seepage pit 11 Fuel storage 16 Other (specify below)
 2 Sewer lines 7 Pit privy 12 Fertilizer storage

3 Watertight sewer lines 8 Sewage lagoon 13 Insecticide storage

4 Lateral lines 9 Feedyard 14 Abandoned water well

5 Cess pool 10 Livestock pens 15 Oil well/Gas well

Direction from well?

How many feet?

FROM	TO	PLUGGING MATERIALS
<u>51</u>	<u>4</u>	<u>Hole Plug</u>
<u>4</u>	<u>0</u>	<u>Top soil</u>

7 CONTRACTOR'S OR LANDOWNER'S CERTIFICATION: This water well was plugged under my jurisdiction and was completed on (mo/day/year) 12/29/21 and this record is true to the best of my knowledge and belief. Kansas Water Well Contractor's License No. 672 This Water Well Record was completed on (mo/day/year) 12/29/21 under the business name of Crowdis Water Well Service
 by (signature) [Signature]

INSTRUCTIONS: Use typewriter or ball point pen. Please press firmly and print clearly. Please fill in blanks, underline or circle the correct answers. Send top three copies to Kansas Department of Health and Environment, Bureau of Water, Geology Section, 1000 SW Jackson St., Ste. 420, Topeka, Kansas 66612-1367. Telephone: 785/296-5522. Send one to Water Well Owner and retain one for your records.