


1 LOCATION OF WATER WELL: County: Pratt Fracture: NE 1/4 NE 1/4 SE 1/4 Section Number: 21 Township Number: T 27 S Range Number: R 12 E/W

Distance and direction from nearest town or city street address of well if located within city? 4 miles West 1 North of Cass, Kansas

2 WATER WELL OWNER: Patrick Beck 60176-15 Th Street RR#, St. Address, Box #: PO Box 869 Pratt Kansas 67124 City, State, ZIP Code: Board of Agriculture, Division of Water Resources Application Number:

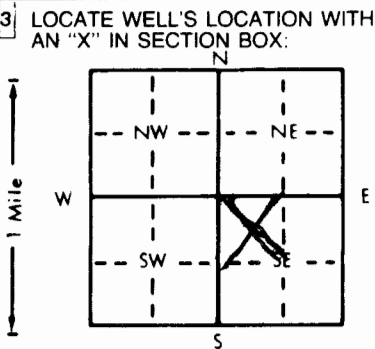

4 DEPTH OF COMPLETED WELL: 80 ft. ELEVATION: Depth(s) Groundwater Encountered: 1. 55 ft. 2. ft. 3. ft. WELL'S STATIC WATER LEVEL: 55 ft. below land surface measured on mo/day/yr 10 24 97 Pump test data: Well water was ft. after hours pumping gpm Est. Yield gpm: Well water was ft. after hours pumping gpm Bore Hole Diameter: 12 in. to 80 ft., and in. to ft. WELL WATER TO BE USED AS: 5 Public water supply 8 Air conditioning 11 Injection well 1 Domestic 3 Feedlot 6 Oil field water supply 9 Dewatering 12 Other (Specify below) 2 Irrigation 4 Industrial 7 Lawn and garden only 10 Monitoring well Was a chemical/bacteriological sample submitted to Department? Yes No ; If yes, mo/day/yr sample was submitted Water Well Disinfected? Yes  No

5 TYPE OF BLANK CASING USED: 1 Steel 3 RMP (SR) 5 Wrought iron 8 Concrete tile CASING JOINTS: Glued Clamped 2 PVC 4 ABS 6 Asbestos-Cement 9 Other (specify below) Welded 7 Fiberglass Threaded Blank casing diameter: 5 in. to 60 ft. Dia. in. to ft. Dia. in. to ft. Casing height above land surface: 2 foot in. weight lbs./ft. Wall thickness or gauge No. TYPE OF SCREEN OR PERFORATION MATERIAL: 1 Steel 3 Stainless steel 5 Fiberglass 8 RMP (SR) 10 Asbestos-cement 2 Brass 4 Galvanized steel 6 Concrete tile 9 ABS 11 Other (specify) 12 None used (open hole) SCREEN OR PERFORATION OPENINGS ARE: 1 Continuous slot 3 Mill slot 5 Gauzed wrapped 8 Saw cut 11 None (open hole) 2 Louvered shutter 4 Key punched 6 Wire wrapped 9 Drilled holes 10 Other (specify) 7 Torch cut SCREEN-PERFORATED INTERVALS: From 60 ft. to 80 ft., From ft. to ft. From ft. to ft. GRAVEL PACK INTERVALS: From 10 ft. to 70 ft., From ft. to ft. From ft. to ft.

6 GROUT MATERIAL: 1 Neat cement 2 Cement grout 3 Bentonite 4 Other Grout Intervals: From 1 ft. to 10 ft., From ft. to ft. to ft. What is the nearest source of possible contamination: 1 Septic tank 4 Lateral lines 7 Pit privy 10 Livestock pens 14 Abandoned water well 2 Sewer lines 5 Cess pool 8 Sewage lagoon 11 Fuel storage 15 Oil well/Gas well 3 Watertight sewer lines 6 Seepage pit 9 Feedyard 12 Fertilizer storage 16 Other (specify below) Pasture well 13 Insecticide storage Stack Direction from well? How many feet?

FROM	TO	LITHOLOGIC LOG	FROM	TO	PLUGGING INTERVALS
0	1	Top Soil			
10	20	Soft fine			
20	30	Soft			
30	40	Soft			
40	50	Soft			
50	60	Clay & Sand			
70	80	Acidul ground			
Total Dept of well <u>80 feet</u> clay Bottom					

7 CONTRACTOR'S OR LANDOWNER'S CERTIFICATION: This water well was (1) constructed, (2) reconstructed, or (3) plugged under my jurisdiction and was completed on (mo/day/year) 10 24 97 and this record is true to the best of my knowledge and belief, Kansas Water Well Contractor's License No. 226 This Water Well Record was completed on (mo/day/yr) 10 24 97 under the business name of Weber Well Service by (signature) James H. Weber

INSTRUCTIONS: Use typewriter or ball point pen PLEASE PRESS FIRMLY and PRINT clearly. Please fill in blanks, underline or circle the correct answers. Send top three copies to Kansas Department of Health and Environment, Bureau of Water, Topeka, Kansas 66620-0001. Telephone: 913-296-5545. Send one to WATER WELL OWNER and retain one for your records.

OFFICE USE ONLY T R E W SEC 1/4 1/4 1/4