


1 LOCATION OF WATER WELL: County: Pratt	Fraction $\frac{1}{4}$ NC $\frac{1}{4}$ NE $\frac{1}{4}$	Section Number 1	Township Number T 27 S	Range Number R 12 EW
---	---	----------------------------	----------------------------------	--------------------------------

Distance and direction from nearest town or city street address of well if located within city?
 Approximately 2 miles south and 1 1/4 miles west of Preston

2 WATER WELL OWNER: **Donald G. Fisher**
 RR#, St. Address, Box #: **90124 NE 110th Street**
 City, State, ZIP Code: **Preston, KS 67583**
 Board of Agriculture, Division of Water Resources
 Application Number:

3 LOCATE WELL'S LOCATION WITH AN "X" IN SECTION BOX:

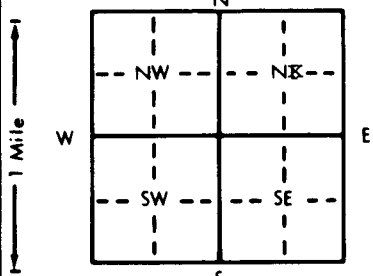

4 DEPTH OF COMPLETED WELL: **140** ft. ELEVATION: **Unknown**

Depth(s) Groundwater Encountered 1. ft. 2. ft. 3. ft.
 WELL'S STATIC WATER LEVEL **51, 10** ft. below land surface measured on **mo/day/yr 7-21-99**
 Pump test data: Well water was **not ch'd** ft. after hours pumping gpm
 Est. Yield **unknown** gpm: Well water was ft. after hours pumping gpm
 Bore Hole Diameter **6** in. to **140** ft., and in. to ft.
 WELL WATER TO BE USED AS:
 5 Public water supply 8 Air conditioning 11 Injection well
 1 Domestic 3 Feedlot 6 Oil field water supply 9 Dewatering 12 Other (Specify below)
 2 Irrigation 4 Industrial 7 Lawn and garden only 10 Monitoring well **Observation Well**
 Was a chemical/bacteriological sample submitted to Department? Yes No **X**; If yes, mo/day/yr sample was submitted
 Water Well Disinfected? Yes No **X**

5 TYPE OF BLANK CASING USED:
 1 Steel 3 RMP (SR) 5 Wrought iron 8 Concrete tile CASING JOINTS: Glued **X** Clamped
 2 PVC 4 ABS 6 Asbestos-Cement 9 Other (specify below) Welded
 7 Fiberglass Threaded

Blank casing diameter **2 1/2** in. to **133** ft., Dia in. to ft., Dia in. to ft.
 Casing height above land surface **24** in., weight **63** lbs./ft. Wall thickness or gauge No. **110**

TYPE OF SCREEN OR PERFORATION MATERIAL:
 1 Steel 3 Stainless steel 5 Fiberglass 7 PVC 10 Asbestos-cement
 2 Brass 4 Galvanized steel 6 Concrete tile 8 RMP (SR) 11 Other (specify)
 9 ABS 12 None used (open hole)

SCREEN OR PERFORATION OPENINGS ARE:
 1 Continuous slot 3 Mill slot 5 Gauzed wrapped 8 Saw cut 11 None (open hole)
 2 Louvered shutter 4 Key punched 6 Wire wrapped 9 Drilled holes
 7 Torch cut 10 Other (specify)

SCREEN-PERFORATED INTERVALS: From **133** ft. to **138** ft., From ft. to ft.
 From ft. to ft., From ft. to ft.
 GRAVEL PACK INTERVALS: From **130** ft. to **140** ft., From ft. to ft.
 From ft. to ft., From ft. to ft.

6 GROUT MATERIAL: **Sand** 1 Neat cement 2 Cement grout 3 Bentonite 4 Other **Bentonite Holeplug**
 Grout Intervals: From **20** ft. to **125** ft., From ft. to ft., From **0 - 20** ft. to **125 - 130** ft.

What is the nearest source of possible contamination:
 1 Septic tank 4 Lateral lines 7 Pit privy 10 Livestock pens 14 Abandoned water well
 2 Sewer lines 5 Cess pool 8 Sewage lagoon 11 Fuel storage 15 Oil well/Gas well
 3 Watertight sewer lines 6 Seepage pit 9 Feedyard 12 Fertilizer storage 16 Other (specify below)
 13 Insecticide storage None known

Direction from well? How many feet?

FROM	TO	LITHOLOGIC LOG	FROM	TO	PLUGGING INTERVALS
0	11	Topsoil			
11	51	Clay, brown			
51	91	Clay, gray			
91	103	Sand and gravel, medium, fine			
103	108	Clay, brown			
108	124	Sand and gravel, medium, fine			
124	127	Clay, tan			
127	130	Sand and gravel, medium, fine			
130	131	Clay, tan			
131	138	Sand and gravel, medium, fine			
138	140	Clay, brown			

7 CONTRACTOR'S OR LANDOWNER'S CERTIFICATION: This water well was (1) constructed, (2) reconstructed, or (3) plugged under my jurisdiction and was completed on (mo/day/year) **7-21-99** and this record is true to the best of my knowledge and belief. Kansas Water Well Contractor's License No. **185** This Water Well Record was completed on (mo/day/yr) **7-26-99** under the business name of **Clarke Well & Equipment, Inc.** by (signature) *Clarke Well & Equipment, Inc.*