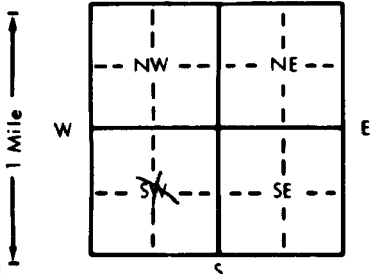


1 LOCATION OF WATER WELL: Fraction $\frac{1}{4}$ N/C $\frac{1}{4}$ SW $\frac{1}{4}$ Section Number 16 Township Number T 27 S Range Number R 12 ~~EW~~
 County: Pratt

Distance and direction from nearest town or city street address of well if located within city?
 1 $\frac{3}{4}$ south, $1\frac{1}{2}$ east of Natrona, Ks.

2 WATER WELL OWNER: Ramblin Rose Ranch
 RR#, St. Address, Box # : 60176 NE 15th St. Board of Agriculture, Division of Water Resources
 City, State, ZIP Code : Pratt, Ks. 67124 Application Number:

3 LOCATE WELL'S LOCATION WITH AN "X" IN SECTION BOX:

 4 DEPTH OF COMPLETED WELL . 155 ft. ELEVATION: ft.
 Depth(s) Groundwater Encountered 1. ft. 2. ft. 3. ft.
 WELL'S STATIC WATER LEVEL . . . 30 ft. below land surface measured on mo/day/yr . . . 7-14-99
 Pump test data: Well water was ft. after hours pumping gpm
 Est. Yield . . NA gpm: Well water was ft. after hours pumping gpm
 Bore Hole Diameter . . 7 in. to . . 155 ft., and in. to ft.
 WELL WATER TO BE USED AS: 5 Public water supply 8 Air conditioning 11 Injection well
 1 Domestic 3 Feedlot 6 Oil field water supply 9 Dewatering 12 Other (Specify below)
 2 Irrigation 4 Industrial 7 Lawn and garden only 10 Monitoring well Test hole
 Was a chemical/bacteriological sample submitted to Department? Yes . . X No ; If yes, mo/day/yr sample was submitted 7-14-99 Water Well Disinfected? Yes No X

5 TYPE OF BLANK CASING USED: 5 Wrought iron 8 Concrete tile CASING JOINTS: Glued . . X Clamped
 1 Steel 3 RMP (SR) 6 Asbestos-Cement 9 Other (specify below) Welded
 2 PVC 4 ABS 7 Fiberglass Threaded
 Blank casing diameter . . $3\frac{1}{2}$ in. to . . 145 ft., Dia in. to ft., Dia in. to ft.
 Casing height above land surface 2' in., weight SCH 80 lbs./ft. Wall thickness or gauge No.
 TYPE OF SCREEN OR PERFORATION MATERIAL: 7 PVC 10 Asbestos-cement
 1 Steel 3 Stainless steel 5 Fiberglass 8 RMP (SR) 11 Other (specify)
 2 Brass 4 Galvanized steel 6 Concrete tile 9 ABS 12 None used (open hole)
 SCREEN OR PERFORATION OPENINGS ARE: 5 Gauzed wrapped 8 Saw cut 11 None (open hole)
 1 Continuous slot 3 Mill slot 6 Wire wrapped 9 Drilled Holes
 2 Louvered shutter 4 Key punched 7 Torch cut 10 Other (specify)
 SCREEN-PERFORATED INTERVALS: From 145 ft. to 150 ft., From ft. to ft.
 From ft. to ft., From ft. to ft.
 GRAVEL PACK INTERVALS: From 155 ft. to 139 ft., From ft. to ft.
 From ft. to ft., From ft. to ft.

6 GROUT MATERIAL: 1 Neat cement 2 Cement grout 3 Bentonite 4 Other . Hole plug . 30' to 0'
 Grout intervals: From . 136 ft. to . 30 ft., From ft. to ft., From . . 139 ft. to . 136 ft.
 What is the nearest source of possible contamination:
 1 Septic tank 4 Lateral lines 7 Pit privy 10 Livestock pens 14 Abandoned water well
 2 Sewer lines 5 Cess pool 8 Sewage lagoon 11 Fuel storage 15 Oil well/Gas well
 3 Watertight sewer lines 6 Seepage pit 9 Feedyard 12 Fertilizer storage 16 Other (specify below) House
 Direction from well? South How many feet? $\frac{1}{4}$ Mile

FROM	TO	LITHOLOGIC LOG	FROM	TO	PLUGGING INTERVALS
0	3	Top soil			
3	14	Brown and white clay			
14	45	Sand and gravel loose coarse with some white rock			
45	60	Brown clay			
60	68	Sand and gravel coarse and loose			
68	73	Sand and gravel with clay mixed			
73	118	Sand and gravel clean coarse loose			
118	148	Gray brown and white clay			
148	150	Sand and gravel			
150	155	Red Bed			

7 CONTRACTOR'S OR LANDOWNER'S CERTIFICATION: This water well was (1) constructed, (2) reconstructed, or (3) plugged under my jurisdiction and was completed on (mo/day/year) 10-15-99 and this record is true to the best of my knowledge and belief. Kansas Water Well Contractor's License No. . . . 134 This Water Well Record was completed on (mo/day/yr) . . 10-18-99 under the business name of Rosencrantz-Bemis by (signature) *Mredia Radson*

OFFICE USE ONLY
T
R
EW
SEC.
 $\frac{1}{4}$
 $\frac{1}{4}$
 $\frac{1}{4}$