


WATER WELL RECORD Form WWC-5 KSA 82a-1212

1 LOCATION OF WATER WELL:
County: Pratt
Fraction: NW 1/4 NE 1/4 SE 1/4
Section Number: 7
Township Number: T 27 S
Range Number: R 12 EW

Distance and direction from nearest town or city street address of well if located within city?
2 3/4 east and 1 1/8 south of Tuka, Ks.

2 WATER WELL OWNER: Pratt well Service INC.
RR#, St. Address, Box #: P.O. Box 847
City, State, ZIP Code: Pratt, Ks. 67124
Board of Agriculture, Division of Water Resources
Application Number:

3 LOCATE WELL'S LOCATION WITH AN "X" IN SECTION BOX:
4 DEPTH OF COMPLETED WELL: 46 ft. ELEVATION:

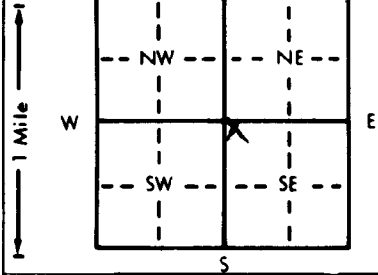

Depth(s) Groundwater Encountered
WELL'S STATIC WATER LEVEL: 10 ft. below land surface
Pump test data: Well water was ... ft. after ... hours pumping ... gpm
Est. Yield: NA gpm
Bore Hole Diameter: 7 in. to 46 in.
WELL WATER TO BE USED AS: 5 Public water supply, 8 Air conditioning, 11 Injection well, etc.

5 TYPE OF BLANK CASING USED:
1 Steel, 2 PVC, 3 RMP (SR), 4 ABS, 5 Wrought iron, 6 Asbestos-Cement, 7 Fiberglass, 8 Concrete tile, 9 Other (specify below), 10 Asbestos-cement

Blank casing diameter: 2 in. to 41 ft., Dia. in. to ... ft., Dia. in. to ... ft.
Casing height above land surface: 3 ft., in., weight Sch. 40 lbs./ft. Wall thickness or gauge No.

TYPE OF SCREEN OR PERFORATION MATERIAL:
1 Steel, 2 Brass, 3 Stainless steel, 4 Galvanized steel, 5 Fiberglass, 6 Concrete tile, 7 PVC, 8 RMP (SR), 9 ABS, 10 Asbestos-cement, 11 Other (specify), 12 None used (open hole)

SCREEN OR PERFORATION OPENINGS ARE:
1 Continuous slot, 2 Louvered shutter, 3 Mill slot, 4 Key punched, 5 Gauzed wrapped, 6 Wire wrapped, 7 Torch cut, 8 Saw cut, 9 Drilled holes, 10 Other (specify), 11 None (open hole)

SCREEN-PERFORATED INTERVALS: From 41 ft. to 46 ft.
GRAVEL PACK INTERVALS: From 46 ft. to 39 ft.

6 GROUT MATERIAL:
1 Neat cement, 2 Cement grout, 3 Bentonite, 4 Other Hole plug
Grout intervals: From 39 ft. to 0 ft.

What is the nearest source of possible contamination:
1 Septic tank, 2 Sewer lines, 3 Watertight sewer lines, 4 Lateral lines, 5 Cess pool, 6 Seepage pit, 7 Pit privy, 8 Sewage lagoon, 9 Feedyard, 10 Livestock pens, 11 Fuel storage, 12 Fertilizer storage, 13 Insecticide storage, 14 Abandoned water well, 15 Oil well/Gas well, 16 Other (specify below) Disposal well
Direction from well? South
How many feet? 145ft. 8"

Table with columns: FROM, TO, LITHOLOGIC LOG, FROM, TO, PLUGGING INTERVALS. Contains log entries for soil, sandy clay, white clay, sand and clay, and red clay.

7 CONTRACTOR'S OR LANDOWNER'S CERTIFICATION: This water well was (1) constructed, (2) reconstructed, or (3) plugged under my jurisdiction and was completed on (mo/day/year) 02-29-00 and this record is true to the best of my knowledge and belief. Kansas Water Well Contractor's License No. 134. This Water Well Record was completed on (mo/day/yr) 03-01-00 under the business name of Rosencrantz-Bemis by (signature) Fredia Redson