


1 LOCATION OF WATER WELL:	Fraction	Section Number	Township Number	Range Number
County: Pratt	SW 1/4 NW 1/4 NW 1/4	36	T 27 S	R 12 E W

Distance and direction from nearest town or city street address of well if located within city?
 Approximately 2 miles west and 1/2 mile north of Cairo

2 WATER WELL OWNER: Jim Bergner
 RR#, St. Address, Box # 412 NE 80th Ave. Board of Agriculture, Division of Water Resources
 City, State, ZIP Code Pratt, KS 67124 Application Number:

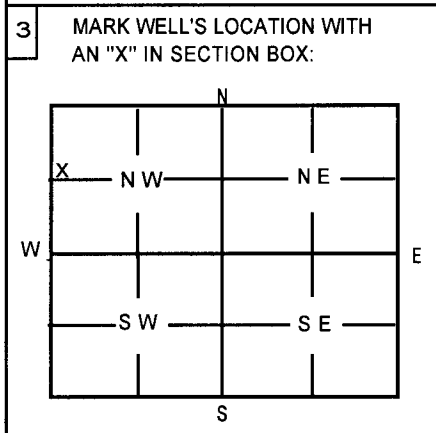

4 DEPTH OF WELL 30 ft
 WELL'S STATIC WATER LEVEL 15 ft
 WELL WAS USED AS:

1 Domestic	5 Public Water Supply	9 Dewatering
2 Irrigation	6 Oil Field Water Supply	10 Monitoring Well
3 Feedlot	7 Domestic (Lawn & Garden)	11 Injection Well
4 Industrial	8 Air Conditioning	12 Other

Was a chemical / bacteriological sample submitted to Department? Yes _____ No
 If yes, mo/day/yr sample was submitted _____
 Water Well Disinfected: Yes No _____

5 TYPE OF BLANK CASING USED:

1 Steel	3 RMP (SR)	5 Wrought	7 Fiberglass	9 Other (Specify below)
2 PVC	4 ABS	6 Asbestos-Cement	8 Concrete Tile	

Blank casing diameter 4 in. Was casing pulled? Yes _____ No
 Casing height above or below land surface 72 in. If yes, how much In Cellar _____

6 GROUT PLUG MATERIAL: 1 Neat Cement 2 Cement grout 3 Bentonite 4 Other Bentonite Holeplug
 Grout Plug Intervals: From _____ ft. to _____ ft., From _____ ft. to _____ ft. From 18 ft. to 6 ft.
 What is the nearest source of possible contamination:

1 Septic tank	6 Seepage pit	11 Fuel storage	16 Other (specify below)
2 Sewer lines	7 Pit privy	12 Fertilizer storage	<u>None known</u>
3 Watertight sewer lines	8 Sewage lagoon	13 Insecticide storage	
4 Lateral lines	9 Feedyard	14 Abandoned water well	
5 Cess Pool	10 Livestock pens	15 Oil well/Gas well	

Direction from well? _____ How many feet? _____

FROM	TO	PLUGGING MATERIALS
30	18	Chlorinated Sand
18	6	Bentonite Holeplug
6	0	In Cellar

7 CONTRACTOR'S OR LANDOWNER'S CERTIFICATION: This water well was plugged under my jurisdiction and was completed on (mo/day/year) 8-1-00 and this record is true to the best of my knowledge and belief. Kansas Water Well Contractor's License No. 185 This Water Well Record was completed on (mo/day/year) 8-2-00 under the business name of Clarke Well & Equipment, Inc.
 by (signature) *Clarke Well & Equipment*

INSTRUCTIONS: Use typewriter or ball point pen. Please press firmly and print clearly. Please fill in blanks, underline or circle the correct answers. Send top three copies to Kansas Department of Health & Environment, Bureau of Water, Topeka, Kansas 66620-0001. Telephone: 785/296-3565. Send one to Water Well Owner and retain one for your records.