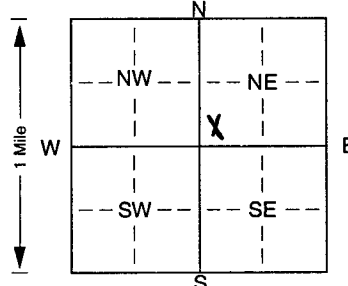


1] LOCATION OF WATER WELL: Fraction SW 1/4 SW 1/4 NE 1/4 Section Number 11 Township Number T 27 S Range Number R 12 EW
 County: Pratt
 Distance and direction from nearest town or city street address of well if located within city?
3 south, 2 1/2 west of Preston, Kansas

2] WATER WELL OWNER: Ramblin Rose Ranch
 RR#, St. Address, Box # : 60176 NE 15th. St. Board of Agriculture, Division of Water Resources
 City, State, ZIP Code : Pratt, Ks. 67124 Application Number: 42,795

3] LOCATE WELL'S LOCATION WITH AN "X" IN SECTION BOX:

 4] DEPTH OF COMPLETED WELL... 91 ft. ELEVATION: ft.
 Depth(s) Groundwater Encountered 1. ft. 2. ft. 3. ft.
 WELL'S STATIC WATER LEVEL... 65 1/2 ft. below land surface measured on mo/day/yr 6-7-00
 Pump test data: Well water was 76' 4" ft. after 2 hours pumping 300 gpm
 Est. Yield 400 gpm: Well water was 80' 3" ft. after 3 1/2 hours pumping 400 gpm
 Bore Hole Diameter... 28 in. to 90 ft., and... in. to... ft.
 WELL WATER TO BE USED AS: 5 Public water supply 8 Air conditioning 11 Injection well
 1 Domestic 3 Feedlot 6 Oil field water supply 9 Dewatering 12 Other (Specify below)
2 Irrigation 4 Industrial 7 Domestic (lawn & garden) 10 Monitoring well
 Was a chemical/bacteriological sample submitted to Department? Yes. No. X ; If yes, mo/day/yrs sample was submitted
 Water Well Disinfected? Yes No X

5] TYPE OF BLANK CASING USED: 5 Wrought iron 8 Concrete tile CASING JOINTS: Glued. X Clamped.
 1 Steel 3 RMP (SR) 6 Asbestos-Cement 9 Other (specify below) Welded
2 PVC 4 ABS 7 Fiberglass Threaded.....
 Blank casing diameter... 16 in. to 82 ft., Dia... in. to... ft., Dia... in. to... ft.
 Casing height above land surface... 12 in., weight Sch. 40 lbs./ft. Wall thickness or gauge No.
 TYPE OF SCREEN OR PERFORATION MATERIAL: 7 PVC 10 Asbestos-cement
 1 Steel 3 Stainless steel 5 Fiberglass 8 RMP (SR) 11 Other (specify)
 2 Brass 4 Galvanized steel 6 Concrete tile 9 ABS 12 None used (open hole)
 SCREEN OR PERFORATION OPENINGS ARE: 5 Gauzed wrapped 8 Saw cut 11 None (open hole)
 1 Continuous slot 3 Mill slot 6 Wire wrapped 9 Drilled holes
 2 Louvered shutter 4 Key punched 7 Torch cut 10 Other (specify) ft.
 SCREEN-PERFORATED INTERVALS: From... 82 ft. to... 90 ft., From... ft. to... ft.
 From... ft. to... ft., From... ft. to... ft.
 GRAVEL PACK INTERVALS: From... 91 ft. to... 20 ft., From... ft. to... ft.
 From... ft. to... ft., From... ft. to... ft.

6] GROUT MATERIAL: 1 Neat cement 2 Cement grout 3 Bentonite 4 Other... Hole plug
 Grout Intervals: From... 20 ft. to... 0 ft., From... ft. to... ft., From... ft. to... ft.
 What is the nearest source of possible contamination:
 1 Septic tank 4 Lateral lines 7 Pit privy 10 Livestock pens 14 Abandoned water well
 2 Sewer lines 5 Cess pool 8 Sewage lagoon 11 Fuel storage 15 Oil well/Gas well
 3 Watertight sewer lines 6 Seepage pit 9 Feedyard 12 Fertilizer storage 16 Other (specify below)
 13 Insecticide storage NONE
 Direction from well? How many feet?

FROM	TO	LITHOLOGIC LOG	FROM	TO	PLUGGING INTERVALS
0	2	Top soil			
2	13	Brown & white clay			
13	15	Sand & gravel			
15	17	Sandy brown clay			
17	51	Sand & gravel, clay, coarse & loose			
51	62	Sand & gravel, mixed w/clay			
62	66	Sand & gravel, loose & clean			
66	70	Sand & clay mixed			
70	89	Sand & gravel medium loose, clean			
89	90	Brown clay			

7] CONTRACTOR'S OR LANDOWNER'S CERTIFICATION: This water well was (1) constructed, (2) reconstructed, or (3) plugged under my jurisdiction and was completed on (mo/day/year) 7-12-00 and this record is true to the best of my knowledge and belief. Kansas Water Well Contractor's Licence No. 134 This Water Well Record was completed on (mo/day/yr) 7-26-00 under the business name of Rosenkrantz-Bemis Ent. by (signature) Jora Alip