


1	LOCATION OF WATER WELL:	Fraction	Section Number	Township Number	Range Number
	County: Pratt	NC 1/4 NE 1/4 SW 1/4	30	27	12

Distance and direction from nearest town or city street address of well if located within city?  
 From the corner of NE 30th Ave and NE 10th Street go 1/2 mile N and east into 1/2 mile

2 WATER WELL OWNER: Beren Corp.  
 RR #, St. Address, Box # 1401 North Park Board of Agriculture, Division of Water Resources  
 City, State, ZIP Code Wellington, KS 67152 Application Number:

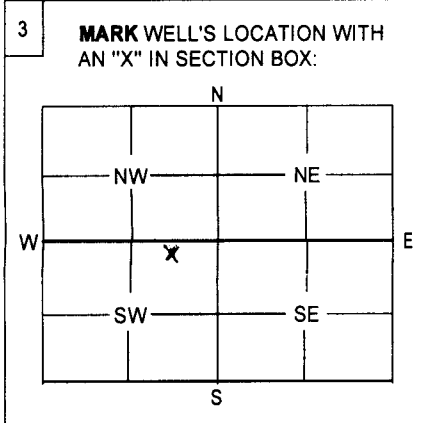

4 DEPTH OF WELL 97.6 ft.  
 WELL'S STATIC WATER LEVEL 64.2 ft.  
 WELL WAS USED AS:  
 1 Domestic 5 Public Water Supply 9 Dewatering  
 2 Irrigation 6 Oil Field Water Supply 10 Monitoring Well  
 3 Feedlot 7 Domestic (Lawn & Garden) 11 Injection Well  
 4 Industrial 8 Air Conditioning 12 Other  
 Was a chemical / bacteriological sample submitted to Department? Yes No   
 if yes, mo/day/yr sample was submitted  
 Water Well Disinfected: Yes No

5 TYPE OF BLANK CASING USED:  
 1 Steel 3 RMP (SR) 5 Wrought 7 Fiberglass 9 Other (Specify below)  
 2 PVC 4 ABS 6 Asbestos-Cement 8 Concrete Tile  
 Blank casing diameter 5 in. Was casing pulled? Yes No   
 Casing height above or below land surface 36 in. If yes, how much

6 GROUT PLUG MATERIAL: 1 Neat cement 2 Cement grout 3 Bentonite 4 Other  
 Grout Plug Intervals: From 97.6 ft. to 0 ft., From ft. to ft., From to ft.  
 What is the nearest source of possible contamination:  
 1 Septic tank 6 Seepage pit 11 Fuel storage 16 Other (specify below)  
 2 Sewer lines 7 Pit privy 12 Fertilizer storage pasture  
 3 Watertight sewer lines 8 Sewage lagoon 13 Insecticide storage  
 4 Lateral lines 9 Feedyard 14 Abandoned water well  
 5 Cess pool 10 Livestock pens 15 Oil well/Gas well  
 Direction from well? IMMEDIATE VICINITY How many feet? IMMEDIATE VICINITY

FROM	TO	PLUGGING MATERIALS
97.6'	0'	Bentonite chips, hydrated

7 CONTRACTOR'S OF LANDOWNER'S CERTIFICATION: This water well was plugged under my jurisdiction and was completed on (mo/day/year) 12/7/09 and this record is true to the best of my knowledge and belief. Kansas Water Well Contractor's License No. 665 This Water Well Record was completed on (mo/day/year) 12/9/09 under the business name of Pratt Well Service, Inc.  
 by (signature) *Steven E. Gill*

INSTRUCTIONS: Use typewriter or ball point pen. Please press firmly and print clearly. Please fill in blanks, underline or circle the correct answers. Send top three copies to Kansas Department of Health and Environment, Bureau of Water, Geology Section, 1 000 SW Jackson St., Ste. 420, Topeka, Kansas 66612-1367. Telephone: 785/296-5522. Send one to Water Well Owner and retain one for your records.

white