USE TYPEWRITER OR BALL POINT PEN-PRESS FIRMLY, PRINT CLEARLY.

WATER WELL RECORD
KSA 82a-1201-1215

Kansas Department of Health and Environment-Division of Environment
(Water well Contractors)
Topeka, Kansas 66620

Fisher #1

1. Location of well:	County	Fraction	Section number	Township number	Range number
	Pratt	C NW NE (1/4 1/4 1/4)	1	T 27 S	R 12 W E/W

2. Distance and direction from nearest town or city: 2 south
Street address of well location if in city: 1/2 West Preston

3. Owner of well: D R Lauck
R.R. or street:
City, state, zip code: Wichita Kansas

4. Locate with "X" in section below:

Sketch map:

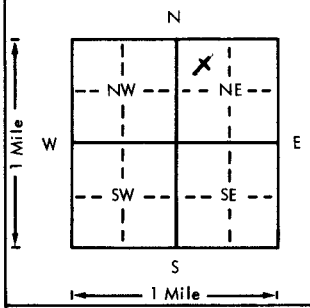

6. Bore hole dia. 8 in. Completion date
Well depth 152 ft. 8-3-77

7. __ Cable tool X Rotary __ Driven __ Dug
__ Hollow rod __ Jetted __ Bored __ Reverse rotary

8. Use: __ Domestic __ Public supply __ Industry
__ Irrigation __ Air conditioning __ Stock
__ Lawn X Oil field water __ Other

9. Casing: Material Plastic Height: Above or below
Threaded ___ Welded X Surface 12 in.
RMP ___ PVC X Weight 287.3 lbs./ft.
Dia. 5 in. to 152 ft. depth Wall Thickness: inches or
Dia. ___ in. to ___ ft. depth gage No. 200

5. Type and color of material	From	To
Sandy Clay	0	85
Sand	85	132
Gravel	132	152

10. Screen: Manufacturer's name Self made
Type PVC Dia. 5
Slot/gauze 1/8 Length 20
Set between 132 ft. and 152 ft.
ft. and ft.
Gravel pack? yes Size range of material 1/8 1/4

11. Static water level: mo./day/yr.
60 ft. below land surface Date 8-3-77

12. Pumping level below land surfaces:
ft. after hrs. pumping g.p.m.
ft. after hrs. pumping g.p.m.
Estimated maximum yield g.p.m.

13. Water sample submitted: mo./day/yr.
__ Yes X No Date

14. Well head completion:
__ Pitless adapter ___ Inches above grade

15. Well grouted? yes
With: __ Neat cement X Bentonite __ Concrete
Depth: From 0 ft. to 10 ft.

16. Nearest source of possible contamination:
ft. Direction Type
Well disinfected upon completion? __ Yes __ No

17. Pump: X Not installed
Manufacturer's name
Model number HP Volts
Length of drop pipe ft. capacity g.p.m.
Type:
__ Submersible __ Turbine
__ Jet __ Reciprocating
__ Centrifugal __ Other

(Use a second sheet if needed)

18. Elevation:

Topography:
__ Hill
X Slope
__ Upland
__ Valley

19. Remarks:

20. Water well contractor's certification:
This well was drilled under my jurisdiction and this report is true to the best of my knowledge and belief.
Business name Myers Water Well
Address Ft Bend Ks License No. 143
Signed Myers Date 8-3-77
Authorized representative

T 27 R 12 W Sec 1 C NW NE 1/4 1/4 1/4

Forward the white, blue and pink copies to the Department of Health and Environment

Form WWC-5

MI-1023