USE TYPEWRITER OR BALL POINT PEN-PRESS FIRMLY, PRINT CLEARLY.

WATER WELL RECORD
KSA 82a-1201-1215

Kansas Department of Health and Environment-Division of Environment
(Water well Contractors)
Topeka, Kansas 66620

1. Location of well:	County	Fraction	Section number	Township number	Range number
	Pratt	1/4 1/4 CSE1/4	12	T 27 S	R 12 E (W)

2. Distance and direction from nearest town or city:
11 miles Northeast of Pratt, KS
Street address of well location if in city:

3. Owner of well: Willard B. Thompson
R.R. or street: Box 997
City, state, zip code: Wichita, KS 67201

4. Locate with "X" in section below: Sketch map:

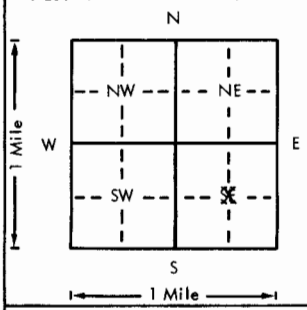

6. Bore hole dia. 24 in. Completion date ~~XXXXX~~ 5-11-77
Well depth 56 ft.

7. __ Cable tool __ Rotary __ Driven __ Dug
__ Hollow rod __ Jetted __ Bored X Reverse rotary

8. Use: __ Domestic __ Public supply __ Industry
X Irrigation __ Air conditioning __ Stock
__ Lawn __ Oil field water __ Other

9. Casing: Material steel Height: Above or below
Threaded ___ Welded xx Surface 12 in.
RMP ___ PVC ___ Weight 30.3 lbs./ft.
Dia. 16 in. to 90 ft. depth Wall Thickness: inches or
Dia. 16 in. to 124 ft. depth gage No. 7 ga.

5. Type and color of material	From	To
Top soil	0	3
Sand & gravel & clay streak at 19'	3	41
Brown ~~XXXX~~ clay	41	43
Sand & gravel streak aty 62'	43	76
Gray clay	76	89
Sand & gravel	89	113
Sand & gravel with thin clay streaks	113	119
Gray clay	119	121
Sand & gravel	121	124
(Use a second sheet if needed)		

10. Screen: Manufacturer's name Cook
Type ___ Dia. 16"
Slot gauze 1/8 Length 30'
Set between 90 ft. and 120 ft.
___ ft. and ___ ft.
Gravel pack? yes Size range of material 3/8-200

11. Static water level: mo./day/yr.
56 ft. below land surface Date 4-8-77

12. Pumping level below land surfaces: N/C
___ ft. after ___ hrs. pumping ___ g.p.m.
___ ft. after ___ hrs. pumping ___ g.p.m.
Estimated maximum yield ___ g.p.m.

13. Water sample submitted: mo./day/yr.
__ Yes X No Date ___

14. Well head completion:
__ Pitless adapter 12 Inches above grade

15. Well grouted? yes
With: X Neat cement ___ Bentonite ___ Concrete
Depth: From 0 ft. to 10 ft.

16. Nearest source of possible contamination: FIELD
ft. ___ Direction ___ Type ___
Well disinfected upon completion? ___ Yes xxx No

17. Pump: __ Not installed
Manufacturer's name Peerless Pump
Model number 12MB-6 HP 75 Volts 460
Length of drop pipe 100 ft. capacity 900 g.p.m.
Type:
__ Submersible X Turbine
__ Jet __ Reciprocating
__ Centrifugal __ Other

T 27 R 12 E (W) Sec 12 1/4 C 1/4 SE 1/4

18. Elevation:
Topography:
__ Hill
__ Slope
__ Upland
__ Valley

19. Remarks:

20. Water well contractor's certification:
This well was drilled under my jurisdiction and this report is true to the best of my knowledge and belief.
Clarke Well & Eq., Inc. 185
Business name License No.
Address Great Bend, KS 67530
Signed [signature] Date 5-16-77
Authorized representative

Forward the white, blue and pink copies to the Department of Health and Environment

Form WWC-5

MI-1023