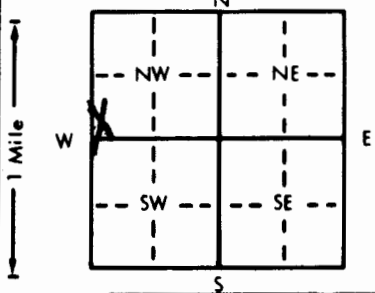


1 LOCATION OF WATER WELL: County: **PRATT** Fraction: **SW 1/4 SW 1/4 NW 1/4** Section Number: **16** Township Number: **T 27 S** Range Number: **R 12 W / EW**

Distance and direction from nearest town or city street address of well if located within city?
75' E. 75" No. of SW Corner of SW 1/4 - NW 1/4 Pratt, KS

2 WATER WELL OWNER: **R.W. Josserand**
 RR#, St. Address, Box #: **1001 Random Rd.** Board of Agriculture, Division of Water Resources
 City, State, ZIP Code: **Pratt, KS.** Application Number: **39134**

3 LOCATE WELL'S LOCATION WITH AN "X" IN SECTION BOX:


4 DEPTH OF COMPLETED WELL: **105** ft. ELEVATION:
 Depth(s) Groundwater Encountered 1. **44** ft. 2. ft. 3. ft.
 WELL'S STATIC WATER LEVEL: **44** ft. below land surface measured on mo/day/yr **3-25-89**
 Pump test data: Well water was ft. after hours pumping gpm
 Est. Yield gpm: Well water was ft. after hours pumping gpm
 Bore Hole Diameter: **30** in. to ft., and in. to ft.
 WELL WATER TO BE USED AS:
 5 Public water supply 8 Air conditioning 11 Injection well
 1 Domestic 3 Feedlot 6 Oil field water supply 9 Dewatering 12 Other (Specify below)
 2 Irrigation 4 Industrial 7 Lawn and garden only 10 Monitoring well
 Was a chemical/bacteriological sample submitted to Department? Yes.....No...**XX**...; If yes, mo/day/yr sample was submitted
 Water Well Disinfected? Yes **XX** No

5 TYPE OF BLANK CASING USED:
 1 Steel **Doerr** 3 RMP (SR) 5 Wrought iron 8 Concrete tile CASING JOINTS: Glued Clamped
 2 PVC 4 ABS 6 Asbestos-Cement 9 Other (specify below) Welded **XX**
 7 Fiberglass Threaded.....
 Blank casing diameter: **16** in. to **65** ft., Dia. in. to ft., Dia. in. to ft.
 Casing height above land surface: **12** in., weight **.219** lbs./ft. Wall thickness or gauge No. **1/4"**
 TYPE OF SCREEN OR PERFORATION MATERIAL:
 1 Steel 3 Stainless steel 5 Fiberglass 8 RMP (SR) 10 Asbestos-cement
 2 Brass 4 Galvanized steel 6 Concrete tile 9 ABS 11 Other (specify)
 12 None used (open hole)
 SCREEN OR PERFORATION OPENINGS ARE:
 1 Continuous slot 3 Mill slot 5 Gauzed wrapped 8 Saw cut 11 None (open hole)
 2 Louvered shutter 4 Key punched 6 Wire wrapped 9 Drilled holes
 7 Torch cut 10 Other (specify)
 SCREEN-PERFORATED INTERVALS: From **65** ft. to **105** ft., From ft. to ft.
 From ft. to ft., From ft. to ft.
 GRAVEL PACK INTERVALS: From **20** ft. to **105** ft., From ft. to ft.
 From ft. to ft., From ft. to ft.

6 GROUT MATERIAL: 1 Neat cement 2 Cement grout 3 Bentonite 4 Other
 Grout Intervals: From **0** ft. to **8** ft., From **8** ft. to **20** ft., From ft. to ft.
 What is the nearest source of possible contamination:
 1 Septic tank 4 Lateral lines 7 Pit privy 10 Livestock pens 14 Abandoned water well
 2 Sewer lines 5 Cess pool 8 Sewage lagoon 11 Fuel storage 15 Oil well/Gas well
 3 Watertight sewer lines 6 Seepage pit 9 Feedyard 12 Fertilizer storage 16 Other (specify below)
 13 Insecticide storage None apparent.....
 Direction from well? How many feet?

FROM	TO	LITHOLOGIC LOG	FROM	TO	PLUGGING INTERVALS
0	2	Fine Sand			
2	25	Fine to Coarse Sand			
25	50	Brown & Tan clay			
50	73	Very Fine To Coarse to Medium Gravel			
73	75	Brown Clay			
75	103	Coarse Sand to Very Coarse Gravel			
103	105	Gray Clay			

7 CONTRACTOR'S OR LANDOWNER'S CERTIFICATION: This water well was (1) constructed, (2) reconstructed, or (3) plugged under my jurisdiction and was completed on (mo/day/year) **3-25-88** and this record is true to the best of my knowledge and belief. Kansas Water Well Contractor's License No. **236** This Water Well Record was completed on (mo/day/year) **5-15-89** under the business name of **Harp Well & Pump Service, Inc.** by signature **Mary Arnold**

OFFICE USE ONLY