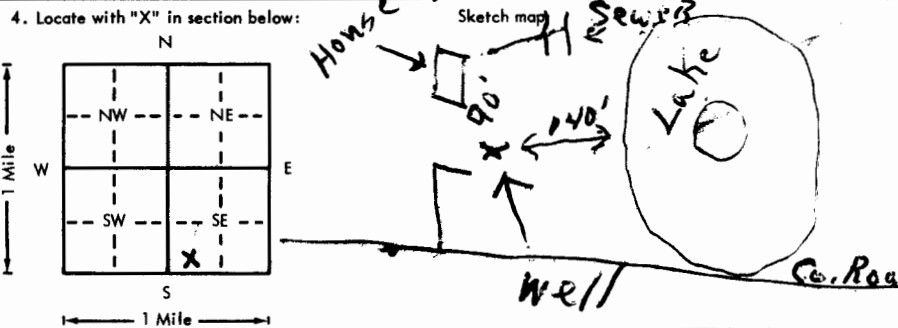


USE TYPEWRITER OR BALL POINT PEN—PRESS FIRMLY—PRINT CLEARLY.

WATER WELL RECORD  
KSA 82a-1201-1215

Kansas Department of Health and Environment—Division of Environment  
(Water well Contractors)  
Topeka, Kansas 66620

1. Location of well: County <b>Pratt</b> Fraction <b>SE 1/4 SW 1/4 S 1/4 E 1/4</b> Section number <b>18</b> Township number <b>T 27 S</b> Range number <b>R 12 E/W</b>	
2. Distance and direction from nearest town or city: <b>5 Miles N.E</b> Street address of well location if in city: <b>Pratt Kans</b> 3. Owner of well: <b>Ralph Seidel</b> R.R. or street: <b>RR</b> City, state, zip code: <b>Pratt Kansas</b>	
4. Locate with "X" in section below:  6. Bore hole dia. <b>6 3/4</b> in. Completion date <b>8-12</b> Well depth <b>60</b> ft.	
5. Type and color of material	
<b>Top Soil</b>	From <b>0</b> To <b>2</b>
<b>Sand</b>	<b>2</b> <b>16</b>
<b>Gravel with some fine sand</b>	<b>16</b> <b>60</b>
7. Cable tool <input checked="" type="checkbox"/> Rotary <input type="checkbox"/> Driven <input type="checkbox"/> Dug <input type="checkbox"/> Hollow rod <input type="checkbox"/> Jetted <input type="checkbox"/> Bored <input type="checkbox"/> Reverse rotary	
8. Use: <input checked="" type="checkbox"/> Domestic <input checked="" type="checkbox"/> Public supply <input type="checkbox"/> Industry <input type="checkbox"/> Irrigation <input type="checkbox"/> Air conditioning <input type="checkbox"/> Stock <input type="checkbox"/> Lawn <input type="checkbox"/> Oil field water <input type="checkbox"/> Other	
9. Casing: Material <b>PVC</b> Height: Above or below surface <b>72</b> in. Threading <b>Welded</b> Surface <b>72</b> in. RMP <b>PVC</b> Weight <b>200</b> lbs./ft. Dia. <b>2</b> in. to <b>60</b> ft. depth Wall Thickness: inches or Dia. <b>200</b> in. to <b>60</b> ft. depth gage No. <b>200</b>	
10. Screens: Manufacturer's name <b>Jess Kent</b> Type <b>RMP</b> Dia. <b>8"</b> Slot/gauze <b>3/16</b> Length <b>30'</b> Set between <b>60</b> ft. and <b>30</b> ft. Gravel pack? <b>Yes</b> Size range of material <b>1/4 X 3/4</b>	
11. Static water level: <b>16</b> ft. below land surface Date <b>8-12-76</b> mo./day/yr.	
12. Pumping level below land surfaces: <b>16</b> ft. after <b>1</b> hrs. pumping <b>150</b> g.p.m. <b>30</b> ft. after <b>3</b> hrs. pumping <b>300</b> g.p.m. Estimated maximum yield <b>300</b> g.p.m.	
13. Water sample submitted: <b>X</b> Yes <b>X</b> No Date _____ mo./day/yr.	
14. Well head completion: <b>12</b> Pitless adapter <b>12</b> Inches above grade	
15. Well grouted? <b>Yes</b> With: <input type="checkbox"/> Neat cement <input type="checkbox"/> Bentonite <input checked="" type="checkbox"/> Concrete Depth: From <b>0</b> ft. to <b>14</b> ft.	
16. Nearest source of possible contamination: <b>150</b> ft. <b>NE</b> Direction <b>Septic</b> Type <b>Septic</b> Well disinfected upon completion? <input checked="" type="checkbox"/> Yes <input type="checkbox"/> No	
17. Pump: <b>Not installed</b> Manufacturer's name <b>Valley</b> Model number _____ HP <b>15</b> Volts <b>220</b> Length of drop pipe <b>42</b> ft. capacity <b>220</b> g.p.m. Type: <input checked="" type="checkbox"/> Submersible <input type="checkbox"/> Turbine <input type="checkbox"/> Jet <input type="checkbox"/> Reciprocating <input type="checkbox"/> Centrifugal <input type="checkbox"/> Other	
(Use a second sheet if needed)	
18. Elevation: Topography: <input type="checkbox"/> Hill <input type="checkbox"/> Slope <input type="checkbox"/> Upland <input checked="" type="checkbox"/> Valley	19. Remarks: <b>Coal/Hayse Water Well 224</b> Business name <b>Coal/Hayse Water Well 224</b> License No. <b>6035 Maple Green</b> Address <b>Pratt Kans</b> Signed <b>Coal/Hayse</b> Date <b>8-12-76</b> Authorized representative

27 120 18 1/4 18 1/4 18 1/4

Forward the white, blue and pink copies to the Department of Health and Environment

Form WWC-5