USE TYPEWRITER OR BALL POINT PEN-PRESS FIRMLY, PRINT CLEARLY.

WATER WELL RECORD
KSA 82a-1201-1215

Kansas Department of Health and Environment-Division of Environment
(Water well Contractors)
Topeka, Kansas 66620

1. Location of well:	County	Fraction	Section number	Township number	Range number
	PRATT	C NE SE (1/4 1/4 1/4)	20	T 27 S	R 12 W E/W

2. Distance and direction from nearest town or city: 1 east
Street address of well location if in city: 3 South Pratt

3. Owner of well: D. R. Lauck Oil Co.
R.R. or street: Wichita Kansas
City, state, zip code:

4. Locate with "X" in section below:

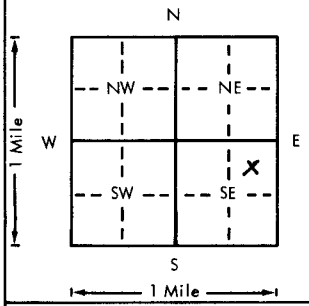

Sketch map:

6. Bore hole dia. 8 in. Completion date
Well depth 25 ft. Feb 25-78

7. __ Cable tool X Rotary __ Driven __ Dug
__ Hollow rod __ Jetted __ Bored __ Reverse rotary

8. Use: __ Domestic __ Public supply __ Industry
__ Irrigation __ Air conditioning __ Stock
__ Lawn X Oil field water __ Other

9. Casing: Material Plastic Height: (Above) or below
Threaded __ Welded X Surface 12 in.
RMP __ PVC X Weight 2873 lbs./ft.
Dia. 5 in. to 25 ft. depth Wall Thickness: inches or
Dia. __ in. to __ ft. depth gage No. 200

10. Screen: Manufacturer's name of Plastic Pipe
Self made
Type PVC Dia. 5
Slot/gauze 1/8 Length 20
Set between 55 ft. and 75 ft.
__ ft. and __ ft.
Gravel pack? yes Size range of material 1/8 1/4

5. Type and color of material	From	To
Clay	0	15
Sandy Clay	15	35
Sand	35	55
Gravel	55	75

(Use a second sheet if needed)

11. Static water level: mo./day/yr.
30 ft. below land surface Date 2-25-78

12. Pumping level below land surfaces:
__ ft. after __ hrs. pumping __ g.p.m.
__ ft. after __ hrs. pumping __ g.p.m.
Estimated maximum yield __ g.p.m.

13. Water sample submitted: mo./day/yr.
__ Yes X No Date

14. Well head completion:
__ Pitless adapter 12 Inches above grade

15. Well grouted? yes
With: __ Neat cement X Bentonite __ Concrete
Depth: From 0 ft. to 10 ft.

16. Nearest source of possible contamination:
ft. __ Direction __ Type
Well disinfected upon completion? __ Yes X No

17. Pump: X Not installed
Manufacturer's name
Model number __ HP __ Volts
Length of drop pipe __ ft. capacity __ g.p.m.
Type:
__ Submersible __ Turbine
__ Jet __ Reciprocating
__ Centrifugal __ Other

T 27 R 12 E/W Sec 20 1/4 1/4 1/4 CNESE

18. Elevation:

Topography:
__ Hill
X Slope
__ Upland
__ Valley

19. Remarks:

20. Water well contractor's certification:
This well was drilled under my jurisdiction and this report is true to the best of my knowledge and belief.
Myers Water Well
Business name License No.
Address St Bend Ks
Signed A. Myers 2-25-78 Date
Authorized representative

Forward the white, blue and pink copies to the Department of Health and Environment

Form WWC-5

MI-1023