USE TYPEWRITER OR BALL POINT PEN-PRESS FIRMLY, PRINT CLEARLY.

T R EW sec 1/4 1/4 1/4 No.

WATER WELL RECORD
KSA 82a-1201-1215

Kansas State Dept. Of Health
(Water Well Contractors)
Forbes-Bldg. 740
Topeka, Kansas 66620

1 Location of well:	County	Township name	Fraction	Section number	Town number	Range number
	Pratt		NE/4 NW/4	35	27	12

Distance and direction from nearest town or city: 7E-½N/½E of Pratt, Ks
Street address of well location if in city:

3 Owner of well: Bowers Drilling Co. Inc.
Address: Suite 1425-125 N Market, Wichita, Kansas

Locate with "X" in section below:

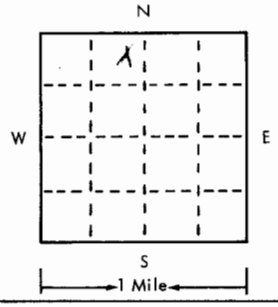

Sketch map:

4 Well depth: 140 ft. Date of completion 2-20-75
Well diameter 7⅞ in.

5 ☐ Cable tool ☒ Rotary ☐ Driven ☐ Dug ☐ Hollow rod ☐ Jetted ☐ Bored ☐ Reverse rotary

6 Use: ☐ Domestic ☐ Public supply ☒ Industry ☐ Irrigation ☐ Air conditioning ☐ Commercial ☐ Test well ☐ Waterflood Oil Field.

7 Casing: Material pvc Height: above/below
Threaded ☐ Welded ☒ Surface 20 in.
Diam. Weight 160 lbs./ft.
4 in. to 100 ft. depth Drive shoe? ☐ Yes ☐ No
___ in. to ___ ft. depth

2 Type and color of material	From	To
Sandy top soil	0	5
Clay	5	30
Good gravel	30	70
Hard	70	72
Clay	72	80
Gravel	80	85
Clay	85	90
Gravel	90	93
Clay	93	102
Sand + gravel	102	120
Clay	120	125
Sand + Gravel	125	132
Clay	132	138
Fire Clay	138	140
(use a second sheet if needed)		

8 Screen:
Manufacturer R.4 B
Type pvc Dia. 4
Slot/gauze 1/16 Length 40'
Set between 100 ft. and 140 ft.
Fittings: 3/4-3/8-1/16
Gravel pack ☒ Yes ☐ No Size range of material Cm 3

9 Static water level:
19 ft. below land surface Date 2-20-75

10 Pumping level below land surfaces:
22 ft. after 1 hrs. pumping 75 g.p.m.
___ ft. after ___ hrs. pumping ___ g.p.m.
Estimated maximum yield 300 g.p.m.

11 Water sample submitted:
☐ Yes ☒ No Date ___

12 Well head completion:
☐ Pitless adapter ☒ Inches above grade

13 Well grouted? ☒ Yes ☐ No
☒ Neat cement ☐ Bentonite ☐ ___
Depth: From 0 ft. to 10 ft.

14 Nearest source of possible contamination:
ft. 300 Direction South Type oil well
Well disinfected upon completion? ☐ Yes ☐ No

15 Pump: ☒ Not installed
Manufacturer's name Red Jacket
Model number 8CC HP 1 Volts 230
Length of drop pipe 63 ft. capacity 18 g.m.p.
Type:
☒ Submersible ☐ Turbine
☐ Jet ☐ Reciprocating
☐ Centrifugal ☐ Other

16 Remarks: elevation
Is a water flood H_2O Well for Oil Field
By discussion with Kyle Podson on 3/11/75 DWB

Topography:
☐ Hill
☐ Slope
☒ Upland
☐ Valley

17 Water well contractor's certification:
This well was drilled under my jurisdiction and this report is true to the best of my knowledge and belief.
Rosencrantz, Bernie 134
Business name License No.
Address Great Bend, Kans.
Signed Fredia Hudson Date 2-24-75
Authorized representative

Forward the white, blue and pink copies to the Kansas State Dept. Of Health.

Form WWC-5

677-H