

WATER WELL RECORD Form WWC-5

PFC KDHE per driller
20170228


Division of Water Resources App. No.

Well ID Stull #1

Original Record Correction Change in Well Use

1 LOCATION OF WATER WELL: County: PRATT Fraction 1/4 NW 1/4 NE 1/4 Section Number 21 Township Number T 27 S Range Number R 12 E W

2 WELL OWNER: Last Name: Siroky First: Oil Management Street or Rural Address where well is located (if unknown, distance and direction from nearest town or intersection): If at owner's address, check here:
Business: Siroky Oil Management Address: P.O. Box 464 City: PRATT State: KS ZIP: 67124 North 1 mile on NB SOD Ave To NE 30th ST 1/2 mile east south out to well

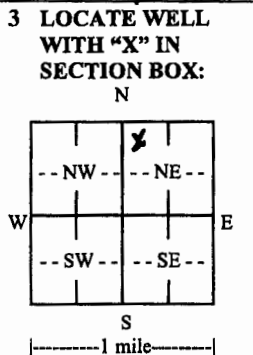

4 DEPTH OF COMPLETED WELL: 90 ft.
Depth(s) Groundwater Encountered: 1) ft.
2) ft. 3) ft., or 4) Dry Well
WELL'S STATIC WATER LEVEL: 78 ft.
 below land surface, measured on (mo-day-yr)
 above land surface, measured on (mo-day-yr) 10-4-17
Pump test data: Well water was ft. after hours pumping gpm
Well water was ft. after hours pumping gpm
Estimated Yield: gpm
Bore Hole Diameter: 10 7/8 in. to 90 ft. and in. to ft.

5 Latitude: (decimal degrees)
Longitude: (decimal degrees)
Horizontal Datum: WGS 84 NAD 83 NAD 27
Source for Latitude/Longitude:
 GPS (unit make/model: (WAAS enabled? Yes No)
 Land Survey Topographic Map
 Online Mapper:
6 Elevation: ft. Ground Level TOC
Source: Land Survey GPS Topographic Map
 Other

7 WELL WATER TO BE USED AS:

1. Domestic: Household Lawn & Garden Livestock
2. Irrigation
3. Feedlot
4. Industrial
5. Public Water Supply: well ID
6. Dewatering: how many wells?
7. Aquifer Recharge: well ID
8. Monitoring: well ID
9. Environmental Remediation: well ID
 Air Sparge Soil Vapor Extraction
 Recovery Injection
10. Oil Field Water Supply: lease Stull #1
11. Test Hole: well ID
 Cased Uncased Geotechnical
12. Geothermal: how many bores?
a) Closed Loop Horizontal Vertical
b) Open Loop Surface Discharge Inj. of Water
13. Other (specify):

Was a chemical/bacteriological sample submitted to KDHE? Yes No If yes, date sample was submitted:

8 TYPE OF CASING USED: Steel PVC Other CASING JOINTS: Glued Clamped Welded Threaded
Casing diameter 5 in. to 70 ft., Diameter in. to ft., Diameter in. to ft.
Casing height above land surface 24 in. Weight SDR 26 lbs./ft. Wall thickness or gauge No.

TYPE OF SCREEN OR PERFORATION MATERIAL:
 Steel Stainless Steel Fiberglass PVC Other (Specify)
 Brass Galvanized Steel Concrete tile None used (open hole)

SCREEN OR PERFORATION OPENINGS ARE:
 Continuous Slot Mill Slot Gauze Wrapped Torch Cut Drilled Holes Other (Specify)
 Louvered Shutter Key Punched Wire Wrapped Saw Cut None (Open Hole)

SCREEN-PERFORATED INTERVALS: From 70 ft. to 90 ft., From ft. to ft., From ft. to ft.
GRAVEL PACK INTERVALS: From 90 ft. to 20 ft., From ft. to ft., From ft. to ft.

9 GROUT MATERIAL: Neat cement Cement grout Bentonite Other
Grout intervals: From 20 ft. to 0 ft., From ft. to ft., From ft. to ft.

Nearest source of possible contamination:
 Septic Tank Lateral Lines Pit Privy Livestock Pens Insecticide Storage
 Sewer Lines Cess Pool Sewage Lagoon Fuel Storage Abandoned Water Well
 Watertight Sewer Lines Seepage Pit Feedyard Fertilizer Storage Oil Well/Gas Well
 Other (Specify)
Direction from well? 999 Distance from well? 999 ft.

10 FROM	TO	LITHOLOGIC LOG	FROM	TO	LITHO. LOG (cont.) or PLUGGING INTERVALS
0	10	Tan Sand Top Soil			
10	20	Tan Clay			
20	35	Fine Tan Sand			
35	50	Bran Clay			
50	60	Tan Sandy Clay			
60	90	Fine Tan Sand			
90	95	Coarse Sand Gravel			

11 CONTRACTOR'S OR LANDOWNER'S CERTIFICATION: This water well was constructed, reconstructed, or plugged under my jurisdiction and was completed on (mo-day-year) 10-4-17 and this record is true to the best of my knowledge and belief. Kansas Water Well Contractor's License No. 672 This Water Well Record was completed on (mo-day-year) 10-4-17 under the business name of Charles Water Well Sol. Signature: [Signature]

Mail 1 white copy along with a fee of \$5.00 for each constructed well to: Kansas Department of Health and Environment, Bureau of Water, GWTS Section, 1000 SW Jackson St., Suite 420, Topeka, Kansas 66612-1367. Mail one to Water Well Owner and retain one for your records. Telephone 785-296-5524. Visit us at <http://www.kdheks.gov/waterwell/index.html> KSA 82a-1212 Revised 7/10/2015