


Original Record Correction Change in Well Use

1 LOCATION OF WATER WELL:
 County: Pratt Fraction: NW 1/4 SE 1/4 SW 1/4 SW 1/4 Section Number: 4 Township Number: T 27 S Range Number: R 12 E W
2 WELL OWNER: Last Name: _____ First: _____ Street or Rural Address where well is located (if unknown, distance and direction from nearest town or intersection): If at owner's address, check here:
 Business: Sterling Drilling Address: Po Box 122 Hwy 61 + NE 50th Ave - go south on NE 50th Ave and 1/4 mile and east into about 690 ft.
 Address: _____ City: Pratt State: KS ZIP: 67124

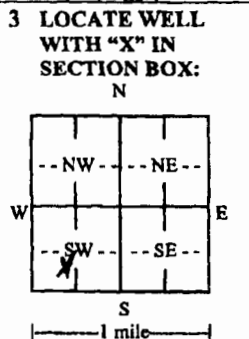

4 DEPTH OF COMPLETED WELL: 95 ft.
 Depth(s) Groundwater Encountered: 1) _____ ft. 2) _____ ft. 3) _____ ft., or 4) Dry Well
 WELL'S STATIC WATER LEVEL: 26 ft.
 below land surface, measured on (mo-day-yr) _____
 above land surface, measured on (mo-day-yr) _____
 Pump test data: Well water was _____ ft. after _____ hours pumping _____ gpm
 Well water was _____ ft. after _____ hours pumping _____ gpm
 Estimated Yield: 100 gpm
 Bore Hole Diameter: 10.78 in. to _____ ft. and _____ in. to _____ ft.

5 Latitude: 37.719461 (decimal degrees)
Longitude: -98.643485 (decimal degrees)
 Horizontal Datum: WGS 84 NAD 83 NAD 27
 Source for Latitude/Longitude:
 GPS (unit make/model: _____) (WAAS enabled? Yes No)
 Land Survey Topographic Map
 Online Mapper: Google Earth Pro
6 Elevation: _____ ft. Ground Level TOC
 Source: Land Survey GPS Topographic Map Other _____

7 WELL WATER TO BE USED AS:

1. Domestic: <input type="checkbox"/> Household <input type="checkbox"/> Lawn & Garden <input type="checkbox"/> Livestock	2. <input type="checkbox"/> Irrigation	3. <input type="checkbox"/> Feedlot	4. <input type="checkbox"/> Industrial	5. <input type="checkbox"/> Public Water Supply: well ID _____	6. <input type="checkbox"/> Dewatering: how many wells? _____	7. <input type="checkbox"/> Aquifer Recharge: well ID _____	8. <input type="checkbox"/> Monitoring: well ID _____	9. Environmental Remediation: well ID _____ <input type="checkbox"/> Air Sparge <input type="checkbox"/> Soil Vapor Extraction <input type="checkbox"/> Recovery <input type="checkbox"/> Injection	10. <input checked="" type="checkbox"/> Oil Field Water Supply: lease <u>Prater Oil</u>	11. Test Hole: well ID _____ <input type="checkbox"/> Cased <input type="checkbox"/> Uncased <input type="checkbox"/> Geotechnical	12. Geothermal: how many bores? _____ a) Closed Loop <input type="checkbox"/> Horizontal <input type="checkbox"/> Vertical b) Open Loop <input type="checkbox"/> Surface Discharge <input type="checkbox"/> Inj. of Water	13. <input type="checkbox"/> Other (specify): _____
--	--	-------------------------------------	--	--	---	---	---	---	---	---	---	---

Was a chemical/bacteriological sample submitted to KDHE? Yes No If yes, date sample was submitted: _____
 Water well disinfected? Yes No

8 TYPE OF CASING USED: Steel PVC Other _____ CASING JOINTS: Glued Clamped Welded Threaded
 Casing diameter 5 in. to _____ ft., Diameter _____ in. to _____ ft., Diameter _____ in. to _____ ft.
 Casing height above land surface 84 in. Weight _____ lbs./ft. Wall thickness or gauge No. _____

TYPE OF SCREEN OR PERFORATION MATERIAL:
 Steel Stainless Steel Fiberglass PVC Other (Specify) _____
 Brass Galvanized Steel Concrete tile None used (open hole)

SCREEN OR PERFORATION OPENINGS ARE:
 Continuous Slot Mill Slot Gauze Wrapped Torch Cut Drilled Holes Other (Specify) _____
 Louvered Shutter Key Punched Wire Wrapped Saw Cut None (Open Hole)

SCREEN-PERFORATED INTERVALS: From 75 ft. to 95 ft., From _____ ft. to _____ ft., From _____ ft. to _____ ft.
GRAVEL PACK INTERVALS: From 75 ft. to 35 ft., From 30 ft. to 21 ft., From _____ ft. to _____ ft.

9 GROUT MATERIAL: Neat cement Cement grout Bentonite Other _____
 Grout Intervals: From 30 ft. to 35 ft., From 21 ft. to 0 ft., From _____ ft. to _____ ft.

Nearest source of possible contamination:
 Septic Tank Lateral Lines Pit Privy Livestock Pens Insecticide Storage
 Sewer Lines Cess Pool Sewage Lagoon Fuel Storage Abandoned Water Well
 Watertight Sewer Lines Seepage Pit Feedyard Fertilizer Storage Oil Well/Gas Well
 Other (Specify) _____
 Direction from well? None Distance from well? _____ ft.

10 FROM	TO	LITHOLOGIC LOG	FROM	TO	LITHO. LOG (cont.) or PLUGGING INTERVALS
0	15	Sandy Top Soil			
15	20	Tan clay			
20	30	Fine Sand			
30	35	Tan Clay			
35	95	Fine Tan to Sand			

11 CONTRACTOR'S OR LANDOWNER'S CERTIFICATION: This water well was constructed, reconstructed, or plugged under my jurisdiction and was completed on (mo-day-year) 3/31/22 and this record is true to the best of my knowledge and belief. Kansas Water Well Contractor's License No. 672 This Water Well Record was completed on (mo-day-year) 4/3/22 under the business name of Crown Water Well Signature _____



ASSIGNMENT OF WATER WELL TO LANDOWNER*
FORM WWC-7

I, BILL STUDER of P.O BOX 925
(Landowner) (Landowner address)

PRATT KANSAS am the landowner on which a water well is located in the
(City) (State)
NW 1/4, SE 1/4, SW 1/4, SW 1/4, Section 4, Township 27 S, Range 12 E W, in
PRATT County, Kansas, and approximately 660' feet NS, and 990 feet EW
of the apparent SW section corner. The water well was drilled in APRIL/2022 (month/year).

I hereby request that STERLING DRILLING COMPANY leave the water well,
(Well operator/owner name)

which was drilled under Temporary/Term Water Permit # 20220061, unplugged, and I will assume all responsibility for properly maintaining said water well in accordance with the requirements of KDHE regulations in K.A.R. 28-30-6 to 28-30-10, including requesting and maintaining said well in inactive status and proper plugging when it is abandoned, in accordance with regulations in K.A.R. 28-30-7.

LANDOWNER:

Billy Studer 7/12/22
(Signature) (Date)

BILL STUDER
(Print)

WELL OWNER:

[Signature] 07/11/2022
(Signature) (Date)

By: DEREK REBEL
(Agent)

IF ADDITIONAL LANDOWNER

(Signature) (Date)

(Print)

*Where the owner of a water well is not the landowner, KDHE regulations in Article 30 [K.A.R. 28-30-7(e)] allow responsibility for the well to be conveyed to the landowner in lieu of abandoning and plugging the well, but the well must conform to the requirements for active or inactive status. The transfer must be made through a legal document, approved by KDHE, advising the landowner of their responsibilities and obligations to properly maintain the well, including the proper plugging of the well when it is abandoned.

Landowners may obtain KDHE's written approval to maintain the well in an inactive status, in accordance with K.A.R. 28-30-7(f), rather than plugging it if the landowner can present evidence as to the well's condition and the landowner's intentions to use the well in the future.

A request for inactive water well status must be submitted to KDHE by completing Form WWC-6 in accordance with Procedure WWP-4. KDHE Water Well Program statutes, regulations, forms, and procedures are available at:

<http://www.kdheks.gov/waterwell/index.html>.