

1 LOCATION OF WATER WELL: Fraction NW ¼ NW ¼ SW ¼ Section Number 34 Township Number T 27 S Range Number R 13 **EW**

Distance and direction from nearest town or city street address of well if located within city?

140' NW corner of Ninnescah St. & Green St.


2 WATER WELL OWNER: Western Light & Telephone Co.

RR#, St. Address, Box # : 102 Green

City, State, ZIP Code : Pratt, Kansas 67124

Board of Agriculture, Division of Water Resources
Application Number:

3 LOCATE WELL'S LOCATION WITH AN "X" IN SECTION BOX:

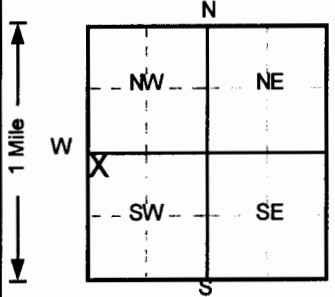

4 DEPTH OF COMPLETED WELL 75 ft ELEVATION: ~~31.34~~

Depth(s) Groundwater Encountered 1. 67 ft 2. 0 ft 3. 0 ft

WELL'S STATIC WATER LEVEL . . . 64.04 . . . ft below land surface measured on mo/day/yr 6/12/95

Pump test data: Well water was . . . NA . . . ft after hours pumping gpm

Est Yield . . NA . . gpm: Well water was ft after hours pumping gpm

Bore Hole Diameter . . . 8 . . . in. to 75 ft, and 0 in. to 0 ft

WELL WATER TO BE USED AS: 5 Public water supply 8 Air conditioning 11 Injection well

1 Domestic 3 Feedlot 6 Oil field water supply 9 Dewatering 12 Other (Specify below)

2 Irrigation 4 Industrial 7 Lawn and garden only **10** Monitoring well

Was a chemical/bacteriological sample submitted to Department: Yes.....No ; If yes, mo/day/yr sample was submitted
Water Well Disinfected? Yes No

5 TYPE OF BLANK CASING USED:

- 1 Steel
- 2** PVC
- 3 RMP (SR)
- 4 ABS
- 5 Wrought iron
- 6 Asbestos-Cement
- 7 Fiberglass
- 8 Concrete tile
- 9 Other (specify below)

CASING JOINTS: Glued Clamped
Welded
Threaded.

Blank casing diameter 2 in. to 55 ft, Dia in. to ft, Dia in. to ft
Casing height above land surface 0 in., weight lbs./ft. Wall thickness or gauge No. Sch. 40

TYPE OF SCREEN OR PERFORATION MATERIAL

- 1 Steel
- 2 Brass
- 3 Stainless steel
- 4 Galvanized steel
- 5 Fiberglass
- 6 Concrete tile
- 7** PVC
- 8 RMP (SR)
- 9 ABS
- 10 Asbestos-cement
- 11 Other (specify)
- 12 None used (open hole)

SCREEN OR PERFORATION OPENINGS ARE:

- 1 Continuous slot
- 2 Louvered shutter
- 3** Mill slot
- 4 Key punched
- 5 Gauzed wrapped
- 6 Wire wrapped
- 7 Torch cut
- 8 Saw cut
- 9 Drilled holes
- 10 Other (specify)
- 11 None (open hole)

SCREEN-PERFORATED INTERVALS: From 55 ft to 75 ft, From ft to ft
From ft to ft, From ft to ft

GRAVEL PACK INTERVALS: From 53 ft to 75 ft, From ft to ft
From ft to ft, From ft to ft

6 GROUT MATERIAL: 1 Neat cement **2** Cement grout **3** Bentonite 4 Other

Grout Intervals: From 0 ft to 53 ft, From 51 ft to 53 ft, From ft to ft

What is the nearest source of possible contamination:

- 1 Septic tank
- 2 Sewer lines
- 3 Watertight sewer lines
- 4 Lateral lines
- 5 Cess pool
- 6 Seepage pit
- 7 Pit privy
- 8 Sewage lagoon
- 9 Feedyard
- 10 Livestock pens
- 11 Fuel storage
- 12 Fertilizer storage
- 13 Insecticide storage
- 14 Abandoned water well
- 15 Oil well/Gas well
- 16** Other (specify below) UST

Direction from well?

FROM	TO	LITHOLOGIC LOG	FROM	TO	PLUGGING INTERVALS
0	7	Clay, Dark Brown			
7	10	Clay, Medium Dark Gray			
10	20	Sand, Dark Red mottled with Dark Gray,			
20	26.5	Sand, Light Yellow-Brown			
26.5	27	Clay, Light Yellow-Brown			
27	30	Sand, Medium Yellow-Brown			
30	35	Sand, Bright Orange-Yellow			
35	40	Sand, Light Yellow Brown			
40	42	Sand, Light Yellow-Brown			
42	50	Sand, Light Yellow-Brown			
50	61	Sand, Light Yellow Brown			
61	75	Sand, Light Yellow-Brown			
					MW1, Tag # 117649, Flush Mount
					Project Name: Western Lite Telephone Co.
					GeoCore # 144, KDHE # U1076900

7 CONTRACTOR'S OR LANDOWNER'S CERTIFICATION: This water well was **1** constructed, (2) reconstructed, or (3) plugged under my jurisdiction and was completed on (mo/day/year) 6/12/95 and this record is true to the best of my knowledge and belief.
Kansas Water Well Contractor's License No. 527 This Water Well Record was completed on (mo/day/yr) 7/7/95
under the business name of **GeoCore Services, Inc.** by (signature) *Doc [unclear]*