WATER WELL RECORD Form WWC-5 KSA 82a-1212

1 LOCATION OF WATER WELL:	Fraction	Section Number	Township Number	Range Number
County: Pratt	NW ¼ NW ¼ SW ¼	34	T 27 S	R 13 E/W

Distance and direction from nearest town or city street address of well if located within city?
70' Northeast of Hwy 281 & Green St.

2 WATER WELL OWNER: Western Light & Telephone Co.
RR#, St. Address, Box # : 102 Green
City, State, ZIP Code : Pratt, Kansas 67124
Board of Agriculture, Division of Water Resources Application Number:

3 LOCATE WELL'S LOCATION WITH AN "X" IN SECTION BOX:

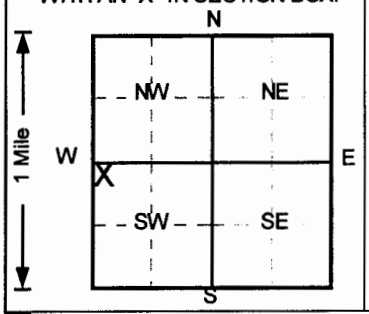

4 DEPTH OF COMPLETED WELL 75 ft. ELEVATION:
Depth(s) Groundwater Encountered 1. 67 ft. 2. 0 ft. 3. 0 ft.
WELL'S STATIC WATER LEVEL 60.91 ft. below land surface measured on mo/day/yr 06/12/95
Pump test data: Well water was NA ft. after ... hours pumping ... gpm
Est. Yield NA gpm: Well water was ... ft. after ... hours pumping ... gpm
Bore Hole Diameter 8 in. to 75 ft., and 0 in. to 0 ft.
WELL WATER TO BE USED AS: 5 Public water supply 8 Air conditioning 11 Injection well
1 Domestic 3 Feedlot 6 Oil field water supply 9 Dewatering 12 Other (Specify below)
2 Irrigation 4 Industrial 7 Lawn and garden only (10) Monitoring well
Was a chemical/bacteriological sample submitted to Department? Yes ..... No ✓ ; If yes, mo/day/yr sample was submitted
Water Well Disinfected? Yes No ✓

5 TYPE OF BLANK CASING USED: 5 Wrought iron 8 Concrete tile CASING JOINTS: Glued ... Clamped ...
1 Steel 3 RMP (SR) 6 Asbestos-Cement 9 Other (specify below) Welded ...
(2) PVC 4 ABS 7 Fiberglass Threaded ✓
Blank casing diameter 2 in. to 55 ft., Dia ... in. to ... ft., Dia ... in. to ... ft.
Casing height above land surface 0 in., weight ... lbs./ft. Wall thickness or gauge No. Sch. 40

TYPE OF SCREEN OR PERFORATION MATERIAL
1 Steel 3 Stainless steel 5 Fiberglass (7) PVC 10 Asbestos-cement
2 Brass 4 Galvanized steel 6 Concrete tile 8 RMP (SR) 11 Other (specify)
9 ABS 12 None used (open hole)

SCREEN OR PERFORATION OPENINGS ARE:
1 Continuous slot (3) Mill slot 5 Gauzed wrapped 8 Saw cut 11 None (open hole)
2 Louvered shutter 4 Key punched 6 Wire wrapped 9 Drilled holes
7 Torch cut 10 Other (specify)

SCREEN-PERFORATED INTERVALS: From 55 ft. to 75 ft., From ... ft. to ... ft
From ... ft. to ... ft., From ... ft. to ... ft
GRAVEL PACK INTERVALS: From 53 ft. to 75 ft., From ... ft. to ... ft
From ... ft. to ... ft., From ... ft. to ... ft

6 GROUT MATERIAL: 1 Neat cement (2) Cement grout (3) Bentonite 4 Other ...
Grout Intervals: From 0 ft. to 53 ft., From 51 ft. to 53 ft., From ... ft. to ... ft

What is the nearest source of possible contamination:
1 Septic tank 4 Lateral lines 7 Pit privy 10 Livestock pens 14 Abandoned water well
2 Sewer lines 5 Cess pool 8 Sewage lagoon 11 Fuel storage 15 Oil well/Gas well
3 Watertight sewer lines 6 Seepage pit 9 Feedyard 12 Fertilizer storage (16) Other (specify below)
13 Insecticide storage UST
Direction from well? How many feet? 0

FROM	TO	LITHOLOGIC LOG	FROM	TO	PLUGGING INTERVALS
0	0.5	Concrete,			
0.5	10	Sand, Medium Orange-Brown			
10	15	Sand, Light Yellow Brown			
15	19	Sand, Light Yellow-Brown			
19	25	Sand, Light Yellow-Brown			
25	41	Sand, Light Yellow Brown			
41	54	Sand, Light Yellow-Orange-Brown			
54	60	Sand, Light Yellow-Orange -Brown			
60	75	Sand, Light Yellow-Brown			
					MW2 , Tag # 117632 , Flush Mount
					Project Name: Western Lite -Telephone Co.
					GeoCore # 144 , KDHE # U1076900

7 CONTRACTOR'S OR LANDOWNER'S CERTIFICATION: This water well was (1) constructed, (2) reconstructed, or (3) plugged under my jurisdiction and was completed on (mo/day/year) 06/12/95 and this record is true to the best of my knowledge and belief. Kansas Water Well Contractor's License No. 527 This Water Well Record was completed on (mo/day/yr) 07/07/95 under the business name of GeoCore Services, Inc. by (signature) Bob Ladd

INSTRUCTIONS: Use typewriter or ball point pen. *PLEASE PRESS FIRMLY* and *PRINT* clearly. Please fill in blanks, underline or circle the correct answers. Send top three copies to Kansas Department of Health and Environment, Bureau of Water, Topeka, Kansas 66620-0001. Telephone: 913-296-5545. Send one to WATER WELL OWNER and retain one for your records.

OFFICE USE ONLY T R E/W SEC. ¼ ¼ ¼