


1 LOCATION OF WATER WELL: Fraction NE 1/4 SE 1/4 NW 1/4 Section Number 3 Township Number T 27 S Range Number R 13 EW
 County: Pratt

Distance and direction from nearest town or city street address of well if located within city?
Summer St. + Mo Pac Railroad, Tuka, KS

2 WATER WELL OWNER: Tuka Cooperative Board of Agriculture, Division of Water Resources
 RR#, St. Address, Box #: Main St. + Mo Pac Railroad Application Number: MW-10
 City, State, ZIP Code: Tuka, KS 67066

3 LOCATE WELL'S LOCATION WITH AN "X" IN SECTION BOX:

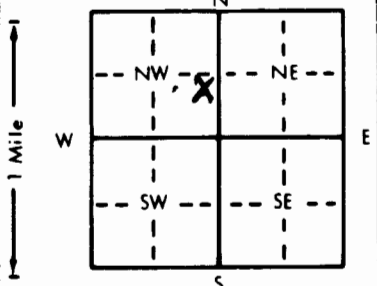

4 DEPTH OF COMPLETED WELL: 64 ft. ELEVATION: _____

Depth(s) Groundwater Encountered 1. 50.15 ft. 2. _____ ft. 3. _____ ft.
 WELL'S STATIC WATER LEVEL: 50.15 ft. below land surface measured on 6/8/95
 Pump test data: Well water was _____ ft. after _____ hours pumping _____ gpm
 Est. Yield _____ gpm Well water was _____ ft. after _____ hours pumping _____ gpm
 Bore Hole Diameter: 8 in. to 6.4 ft., and _____ in. to _____ ft.
 WELL WATER TO BE USED AS:
 5 Public water supply 8 Air conditioning 11 Injection well
 1 Domestic 3 Feedlot 6 Oil field water supply 9 Dewatering 12 Other (Specify below)
 2 Irrigation 4 Industrial 7 Lawn and garden only Monitoring well
 Was a chemical/bacteriological sample submitted to Department? Yes No
 Water Well Disinfected? Yes No

5 TYPE OF BLANK CASING USED:
 1 Steel 3 RMP (SR) 5 Wrought iron 8 Concrete tile CASING JOINTS: Glued _____ Clamped _____
 PVC 4 ABS 7 Fiberglass _____ Welded _____
 Blank casing diameter: 2 in. to 4.4 ft., Dia _____ in. to _____ ft., Dia _____ in. to _____ ft.
 Casing height above land surface: 0 (flush Mt) in., weight _____ lbs./ft. Wall thickness or gauge No. _____

TYPE OF SCREEN OR PERFORATION MATERIAL:
 1 Steel 3 Stainless steel 5 Fiberglass 8 RMP (SR) 10 Asbestos-cement 11 Other (specify) _____
 2 Brass 4 Galvanized steel 6 Concrete tile 9 ABS 12 None used (open hole)

SCREEN OR PERFORATION OPENINGS ARE:
 1 Continuous slot Mill slot 5 Gauzed wrapped 8 Saw cut 11 None (open hole)
 2 Louvered shutter 4 Key punched 6 Wire wrapped 9 Drilled holes
 7 Torch cut 10 Other (specify) _____

SCREEN-PERFORATED INTERVALS: From 44 ft. to 64 ft., From _____ ft. to _____ ft.
 From _____ ft. to _____ ft., From _____ ft. to _____ ft.

GRAVEL PACK INTERVALS: From 43 ft. to 64 ft., From _____ ft. to _____ ft.
 From _____ ft. to _____ ft., From _____ ft. to _____ ft.

6 GROUT MATERIAL: 1 Neat cement 2 Cement grout 3 Bentonite 4 Other _____
 Grout Intervals: From 0 ft. to 41 ft., From 41 ft. to 43 ft., From _____ ft. to _____ ft.

What is the nearest source of possible contamination:
 1 Septic tank 4 Lateral lines 7 Pit privy 10 Livestock pens 14 Abandoned water well
 2 Sewer lines 5 Cess pool 8 Sewage lagoon Fuel storage 15 Oil well/Gas well
 3 Watertight sewer lines 6 Seepage pit 9 Feedyard 12 Fertilizer storage 16 Other (specify below)
 13 Insecticide storage

Direction from well? Southwest How many feet? 350

| FROM | TO | LITHOLOGIC LOG | FROM | TO | PLUGGING INTERVALS |
|------|-----|--|------|----|--------------------|
| 0 | 13 | clay, w/silt, brown | | | |
| 13' | 33' | clay, w/silt, light brown | | | |
| 33' | 40' | silt, w/clay & fine grained sand, orange brown | | | |
| 48' | 64' | silt w/clay & fine grained sand, light brown | | | |

7 CONTRACTOR'S OR LANDOWNER'S CERTIFICATION: This water well was constructed, (2) reconstructed, or (3) plugged under my jurisdiction and was completed on (mo/day/year) 6/7/95 and this record is true to the best of my knowledge and belief. Kansas Water Well Contractor's License No. 438 This Water Well Record was completed on (mo/day/yr) 8/1/95 under the business name of Kansas City Testing Lab by (signature) Charles Houser

OFFICE USE ONLY
T
R
EW
SEC.