


1 LOCATION OF WATER WELL: County: Pratt Fraction: NE 1/4 NE 1/4 NW 1/4 Section Number: 1 Township Number: T 27 S Range Number: R 13 E/W

Distance and direction from nearest town or city street address of well if located within city?
1 1/4 east of Iuka, Ks.

2 WATER WELL OWNER: Don Hullman
 RR#, St. Address, Box #: 30215 NE 20th Ave Board of Agriculture, Division of Water Resources
 City, State, ZIP Code: Pratt, Ks. 67124 Application Number:

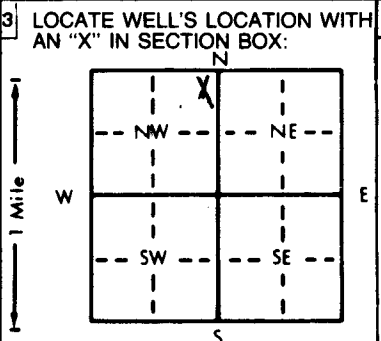

4 DEPTH OF COMPLETED WELL: 140 ft. ELEVATION:
 Depth(s) Groundwater Encountered 1. ft. 2. ft. 3. ft.
 WELL'S STATIC WATER LEVEL ... 40 ft. below land surface measured on mo/day/yr ... 9-25-98
 Pump test data: Well water was ft. after hours pumping gpm
 Est. Yield ... na gpm: Well water was ft. after hours pumping gpm
 Bore Hole Diameter ... 9 7/8 in. to ... 140 ft., and in. to ft.
 WELL WATER TO BE USED AS: 5 Public water supply 8 Air conditioning 11 Injection well
 1 Domestic 3 Feedlot 6 Oil field water supply 9 Dewatering 12 Other (Specify below)
 2 Irrigation 4 Industrial 7 Lawn and garden only 10 Monitoring well ... stock
 Was a chemical/bacteriological sample submitted to Department? Yes.....No...X...; If yes, mo/day/yr sample was submitted
 Water Well Disinfected? Yes hth No

5 TYPE OF BLANK CASING USED: 5 Wrought iron 8 Concrete tile CASING JOINTS: Glued X Clamped
 1 Steel 3 RMP (SR) 6 Asbestos-Cement 9 Other (specify below) Welded
 2 PVC 4 ABS 7 Fiberglass Threaded.....
 Blank casing diameter 5 in. to 120 ft., Dia in. to ft., Dia in. to ft.
 Casing height above land surface 2 in., weight ... SDR 32x8 26 lbs./ft. Wall thickness or gauge No.
 TYPE OF SCREEN OR PERFORATION MATERIAL: 7 PVC 10 Asbestos-cement
 1 Steel 3 Stainless steel 5 Fiberglass 8 RMP (SR) 11 Other (specify)
 2 Brass 4 Galvanized steel 6 Concrete tile 9 ABS 12 None used (open hole)
 SCREEN OR PERFORATION OPENINGS ARE: 5 Gauzed wrapped 8 Saw cut 11 None (open hole)
 1 Continuous slot 3 Mill slot 6 Wire wrapped 9 Drilled holes
 2 Louvered shutter 4 Key punched 7 Torch cut 10 Other (specify)
 SCREEN-PERFORATED INTERVALS: From 140 ft. to 120 ft., From ft. to ft.
 From ft. to ft., From ft. to ft.
 GRAVEL PACK INTERVALS: From 140 ft. to 20 ft., From ft. to ft.
 From ft. to ft., From ft. to ft.

6 GROUT MATERIAL: 1 Neat cement 2 Cement grout 3 Bentonite 4 Other ... hole plug
 Grout Intervals: From 20 ft. to .. 0 ft., From ft. to ft., From ft. to ft.
 What is the nearest source of possible contamination:
 1 Septic tank 4 Lateral lines 7 Pit privy 10 Livestock pens 14 Abandoned water well
 2 Sewer lines 5 Cess pool 8 Sewage lagoon 11 Fuel storage 15 Oil well/Gas well
 3 Watertight sewer lines 6 Seepage pit 9 Feedyard 12 Fertilizer storage 16 Other (specify below)
 13 Insecticide storage none
 Direction from well? How many feet?

FROM	TO	LITHOLOGIC LOG	FROM	TO	PLUGGING INTERVALS
0	3	Top soil	103	108	Sand & gravel medium loose
3	5	Brown & white clay	108	115	Brown & gray clay
5	10	Gray clay	115	140	Sand & gravel clean, coarse & loose
10	22	Brown & gray clay			
22	33	Tough brown clay			
33	47	Brown & white clay			
47	53	Sandy brown clay			
53	59	Fine sand & clay streaks			
59	63	Brown & white sandy clay			
63	66	Fine sand			
66	75	Fine sand and gravel			
75	84	Medium sand and gravel			
84	88	Brown & gray sticky clay			
88	91	Fine sand			
91	103	Brown & white clay			

7 CONTRACTOR'S OR LANDOWNER'S CERTIFICATION: This water well was (1) constructed, (2) reconstructed, or (3) plugged under my jurisdiction and was completed on (mo/day/year) 9-25-98 and this record is true to the best of my knowledge and belief. Kansas Water Well Contractor's License No. 134 This Water Well Record was completed on (mo/day/yr) 10-2-98 under the business name of Rosencrantz-Bemis by (signature) Fredia Nelson

OFFICE USE ONLY
T
R
EW
SEC
1/4
1/4
1/4