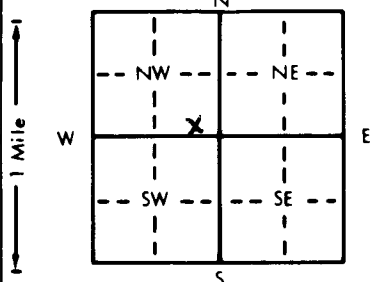


1 LOCATION OF WATER WELL: County: PRATT		Fraction SE 1/4 SE 1/4 NW 1/4	Section Number 3	Township Number T 27 S	Range Number R 13 EW
Distance and direction from nearest town or city street address of well if located within city? MAIN ST. & MO. PAC. RAILROAD, IUKA, KS					
2 WATER WELL OWNER: IUKA COOPERATION EXCHANGE RR#, St. Address, Box #: SUMNER & RAILROAD TRACKS, P.O. Box 175 City, State, ZIP Code: IUKA, KS 67066		Board of Agriculture, Division of Water Resources Application Number:			
3 LOCATE WELL'S LOCATION WITH AN "X" IN SECTION BOX: 		4 DEPTH OF COMPLETED WELL: 55 ft. ELEVATION: 1939.36 G.L. Depth(s) Groundwater Encountered 1. 46 ft. 2. _____ ft. 3. _____ ft. WELL'S STATIC WATER LEVEL 47.15 ft. below land surface measured on mo/day/yr 7/10/97 Pump test data: Well water was _____ ft. after _____ hours pumping _____ gpm Est. Yield _____ gpm: Well water was _____ ft. after _____ hours pumping _____ gpm Bore Hole Diameter 8.25 in. to _____ ft., and _____ in. to _____ ft. WELL WATER TO BE USED AS: 5 Public water supply 8 Air conditioning 11 Injection well 1 Domestic 3 Feedlot 6 Oil field water supply 9 Dewatering 12 Other (Specify below) 2 Irrigation 4 Industrial 7 Lawn and garden only 10 Monitoring well Was a chemical/bacteriological sample submitted to Department? Yes _____ No ☒ ; If yes, mo/day/yr sample was submitted _____ Water Well Disinfected? Yes _____ No ☒			
5 TYPE OF BLANK CASING USED: 1 Steel 3 RMP (SR) 5 Wrought iron 8 Concrete tile 2 PVC 4 ABS 6 Asbestos-Cement 9 Other (specify below) Blank casing diameter 2 in. to 35 ft., Dia. _____ in. to _____ ft., Dia. _____ in. to _____ ft. Casing height above land surface 0 in., weight _____ lbs./ft. Wall thickness or gauge No. _____ TYPE OF SCREEN OR PERFORATION MATERIAL: 1 Steel 3 Stainless steel 5 Fiberglass 7 PVC 10 Asbestos-cement 2 Brass 4 Galvanized steel 6 Concrete tile 9 ABS 11 Other (specify) _____ 12 None used (open hole) SCREEN OR PERFORATION OPENINGS ARE: 1 Continuous slot 3 Mill slot 5 Gauzed wrapped 8 Saw cut 11 None (open hole) 2 Louvered shutter 4 Key punched 6 Wire wrapped 9 Drilled holes 7 Torch cut 10 Other (specify) _____ SCREEN-PERFORATED INTERVALS: From 55 ft. to 35 ft., From _____ ft. to _____ ft. From _____ ft. to _____ ft., From _____ ft. to _____ ft. GRAVEL PACK INTERVALS: From 55 ft. to 33 ft., From _____ ft. to _____ ft. From _____ ft. to _____ ft., From _____ ft. to _____ ft.					
6 GROUT MATERIAL: 1 Neat cement 2 Cement grout 3 Bentonite 4 Other _____ Grout Intervals: From 33 ft. to 31 ft., From 31 ft. to 0 ft., From _____ ft. to _____ ft. What is the nearest source of possible contamination: 1 Septic tank 4 Lateral lines 7 Pit privy 11 Fuel storage 14 Abandoned water well 2 Sewer lines 5 Cess pool 8 Sewage lagoon 12 Fertilizer storage 15 Oil well/Gas well 3 Watertight sewer lines 6 Seepage pit 9 Feedyard 13 Insecticide storage 16 Other (specify below) _____ Direction from well? WEST How many feet? 850'					
FROM TO LITHOLOGIC LOG FROM TO PLUGGING INTERVALS					
0'	4'	SILT, BROWN, CLAYEY, SOME FINE SAND, MOIST			
4'	9'	SOFT, NO ODOR			
9'	14'	CLAY-BROWN-GRAY, SILTY, SOME FINE SAND, MOIST, STIFF, NO ODOR			
14'	39'	CLAY-BROWN, SILTY, MOIST, STIFF, NO ODOR			
39'	44'	SAND, -BROWN, SILTY, FINE, NO ODOR, VERY, MOIST			
44'	49'	SILT-BROWN, FINE SANDY, VERY MOIST, STIFF			
49'	55'	WET AT 46'			
		SAND-BROWN, FINE TO MEDIUM, WET			
7 CONTRACTOR'S OR LANDOWNER'S CERTIFICATION: This water well was 1 constructed, (2) reconstructed, or (3) plugged under my jurisdiction and was completed on (mo/day/year) 7/8/97 and this record is true to the best of my knowledge and belief. Kansas Water Well Contractor's License No. 644 This Water Well Record was completed on (mo/day/yr) 8-4-97 under the business name of Maxim/KCCL by (signature) <i>[Signature]</i>					

INSTRUCTIONS: Use typewriter or ball point pen. PLEASE PRESS FIRMLY and PRINT clearly. Please fill in blanks, underline or circle the correct answers. Send top three copies to Kansas Department of Health and Environment, Bureau of Water, Topeka, Kansas 66620-0001. Telephone: 913-296-5545. Send one to WATER WELL OWNER and retain one for your records.

OFFICE USE ONLY

T

R

EW

SEC.

1/4

1/4

1/4